



Howard T. Phillips, Jr.  
Chairman

Gerard M. Damiani, Jr.  
Executive Director

Rockland County Solid Waste Management Authority

**RFP 2025-02  
REQUEST FOR PROPOSALS  
FOR THE  
RENOVATION OF ROCKLAND GREEN ADMINISTRATIVE HEADQUARTERS  
AND  
CONSTRUCTION OF AN IMMERSIVE THEATRE EXPERIENCE  
AT  
172 MAIN STREET IN NANUET, NY 10954**

**To:** All Potential Proposers  
**From:** Rockland Green  
**Subject:** Addendum Number 3  
**Project:** Rockland Green Renovation & New Immersive Theatre Experience at 172 Main Street, Nanuet, NY 10954  
**RFP No.:** RFP 2025-02  
**Date:** April 10, 2025

---

This Addendum Number 3 is issued to modify the Request for Proposals No. 2025-02 (the “RFP”) for the above referenced project. All potential Proposers are hereby notified of the following change:

**1. Bids**

SEALED BIDS will be received until 2:00 PM. in the office of the Executive Director, on the 25<sup>th</sup> of April 2025, at the Rockland Green Administrative Headquarters, 172 Main Street Nanuet, NY 10954, at which time and place they will be publicly opened and read. Faxed bids will NOT be accepted. One (1) original proposal with five (5) paper copies and one (1) electronic copy on an external drive must be in sealed envelope(s) with the proposer’s name title of the RFP. Sealed envelope(s) must be approximately labeled with the following label:  
“RFP-2025-02 Enclosed”

**2. Contractor Questions**

Following issuance of this RFP, the Proposers may submit written questions to Rockland Green to assist the Proposers in the preparation of their Proposals. Rockland Green may, but shall not be obligated to, respond to such questions. All responses to any questions and requests for additional information which Rockland Green determines to be deserving of response will be issued to all potential Proposers of record in the form of addenda to this RFP which will be issued via email. The last day for submission of written questions have been extended from April 4<sup>th</sup> to April



Howard T. Phillips, Jr.  
Chairman

Gerard M. Damiani, Jr.  
Executive Director

Rockland County Solid Waste Management Authority

17<sup>th</sup>. Any questions submitted after the deadline for questions may be answered by Rockland Green at its discretion.

No oral interpretation, instruction, or information concerning this RFP given by any agent, employee, advisor, or consultant of Rockland Green shall be binding on Rockland Green. Proposers relying on such oral information risk having their response to this RFP deemed unresponsive by Rockland Green. Rockland Green will not be responsible for any explanation or interpretation of this RFP, unless such explanation or interpretation of this RFP is given in accordance with this written procedure.

Should a Proposer find discrepancies in, or omissions from, this RFP, the Proposer shall immediately notify Rockland Green, in writing, and a written addendum, if necessary, will be delivered to each Proposer.

All inquiries, correspondence, questions or clarifications shall be directed to:

Ryan Montal, Confidential Assistant to Executive Director  
Rockland Green  
172 Main Street  
Nanuet, NY 10954  
Email: [rmontal@rocklandgreen.com](mailto:rmontal@rocklandgreen.com)

With a copy to:

John Cirilli, AIA, LEED  
Partner  
Michael Shilale Architects, LLP.  
Email: [jcirilli@shilale.com](mailto:jcirilli@shilale.com)

Except as set forth in this section with regard to procedures for inquiries, correspondence, questions or clarifications, in order to ensure fairness during the procurement process as of the date this RFP is released to the public and throughout the procurement process and negotiations of a Contract, Proposers or their employees, representatives or agents shall not contact any Rockland Green Board member, any Rockland Green employee (other than Ryan Montal or a designated Rockland Green employee or such other individual as instructed by Rockland Green), or any of Rockland Green's technical or legal consultants.

If a Proposer or its employee, representative or agent contacts a Rockland Green Board member, any Rockland Green employee (other than Ryan Montal or a designated Rockland Green employee or such other individual as instructed by Rockland Green), or any of Rockland Green's technical or legal consultants in relation to this RFP, such Proposer risks either being disqualified from submitting a Proposal in response to this RFP or having its Proposal rejected by Rockland Green.

### 3. Revised Drawings

As per attachment 1 see the following revised drawings.

- P002 Revised Gas Load Schedule, Usage (CFH) for DOAS and Total updated.
- M002 Revised Ventilation Schedule to show correct airflow ratings as per code, rearranged schedule so rooms are labelled in order. Revised Dedicated Outdoor Air System Schedule to ensure adequate outside air ventilation is provided.
- M003 Revised Indoor VRF unit schedule, Outdoor VRF Unit Schedule and VRF Heat Recovery Branch Circuit Controller to ensure adequate cooling for the Conference Room.
- M102 Revised Second Floor Plan Piping Layout to ensure adequate cooling is provided for the Conference Room.
- M201 Revised duct layout on First Floor, added return registers in various locations, added fire dampers at fire rated partitions and added General Notes to clarify the work.
- M202 Revised duct layout on Floor to ensure adequate ventilation is provided throughout. Separated duct connections at indoor cassette and added supply diffusers and return registers throughout. Duct sizes are corrected and added General Notes to clarify the work.
- M301 Added Exhaust Air Riser Diagram for all Toilet Exhausts. Revised Ventilation Air Riser Diagram to include all room names and airflow rates.
- M302 Revised VRF Piping Riser Diagram to match floor plans and schedules.
- E001 Revised Communication Symbol list.
- E101 Revised floor plan to include revisions coordinated with Theater, Solar, and Mechanical changes.
- E111 Revised floor plan to include revisions coordinated with mechanical changes.
- E102 Revised floor plan to include revisions coordinated with Solar and mechanical changes.
- E112 Revised floor plan to include revisions coordinated with mechanical changes.
- E103 Revised floor plan to include revisions coordinated with Solar and mechanical changes.
- E104 Revised floor plan to include revisions coordinated with Site design.
- E201 Revised note to include lighting control revisions coordinated with Theater design.
- E203 Revised lighting control design for coordination with theater/exhibit lighting.
- E302 Revised data riser diagram for coordination with floor plan revisions.
- E401 Revised panel schedule to include revisions coordinated with mechanical changes.
- E402 Revised panel schedule to include revisions coordinated with mechanical and theater changes.
- FA001 Revised symbol list to include door holders.
- FA002 Revised riser diagram to include door holders.
- FA101 Revised floor plan to include door holders.

### 4. New Drawings

As per attachment 2 see the following New Drawings.

- A-501 Exterior Details. Additional Handrail details for the North Ramp have been included.




Howard T. Phillips, Jr.  
Chairman

Gerard M. Damiani, Jr.  
Executive Director

Rockland County Solid Waste Management Authority

**ATTACHMENT 1  
TO  
ADDENDUM 3 TO RFP 2025-02**

**REVISED DRAWINGS**

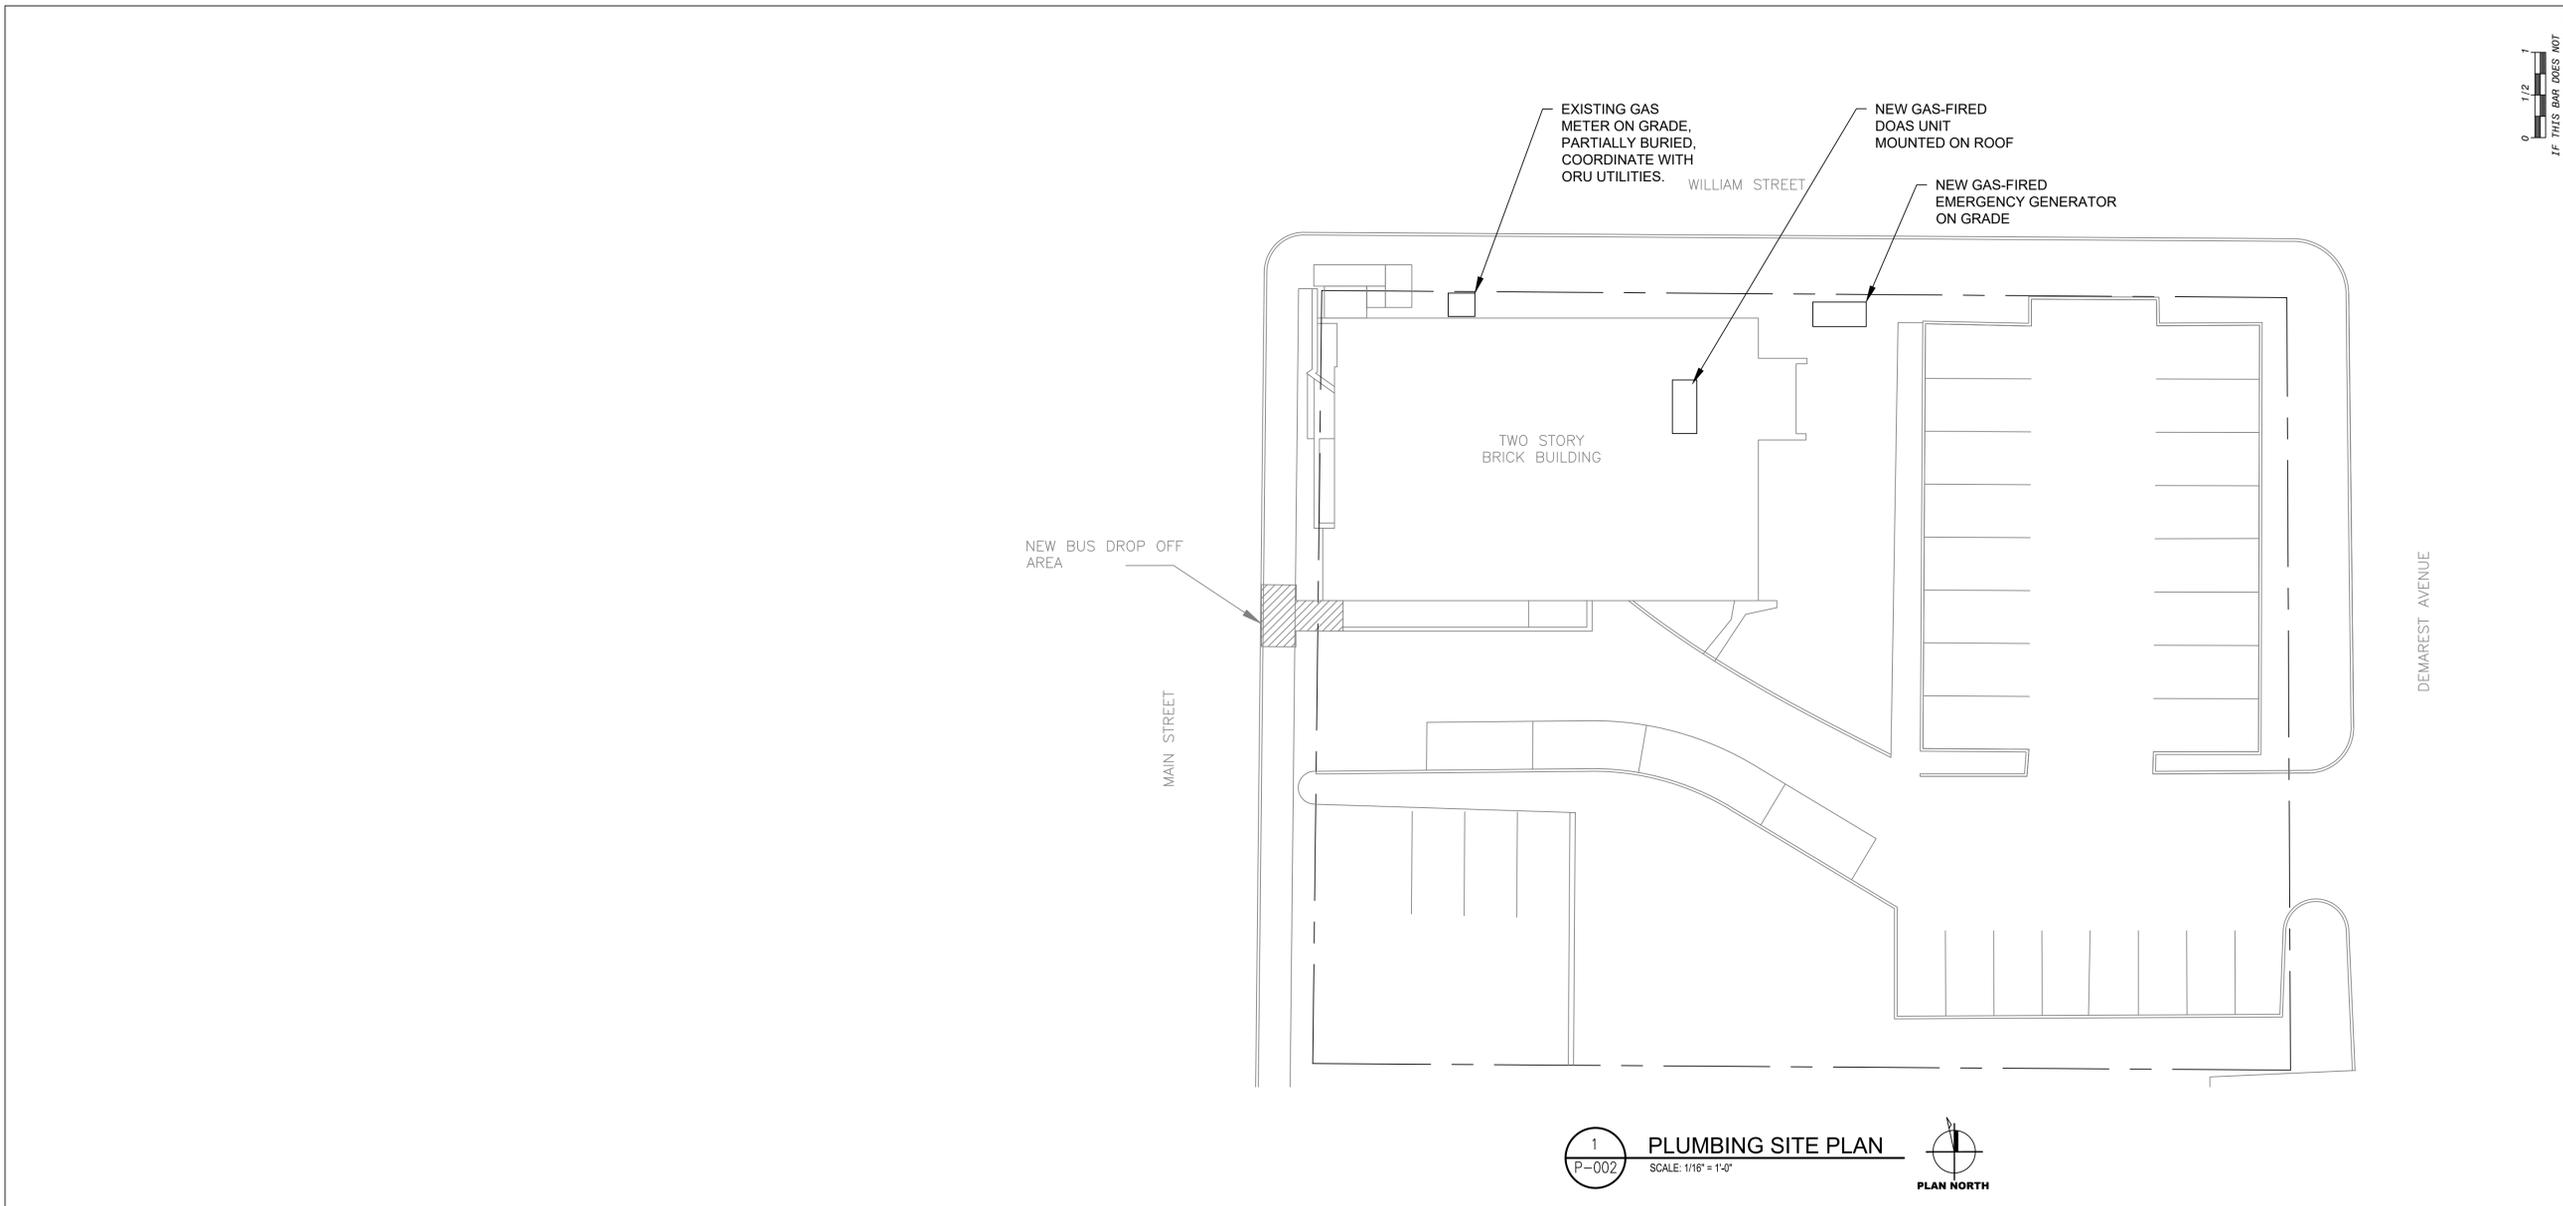

1  
P-002 PLUMBING SITE PLAN  
SCALE: 1/16" = 1'-0"



GAS LOAD SCHEDULE				
LOAD ITEM	LOCATION	USAGE (CFH)	PRESS (W.C.)	STATUS
RTU	ROOF	180	MIN. 4.0", MAX 13"	REMOVE
RTU	ROOF	80	MIN. 4.5", MAX 11"	REMOVE
RTU	ROOF	80	MIN. 4.5", MAX 11"	REMOVE
RTU	ROOF	72	MIN. 4.0", MAX 13"	REMOVE
RTU	ROOF	180	MIN. 4.0", MAX 13"	REMOVE
WATER HEATER	MECHANICAL RM	40	MIN. 5.0", MAX 14"	REPLACE
BOILER	MECHANICAL RM	130	MIN. 4.5", MAX 14"	EXISTING TO REMAIN
DOAS	ROOF	150	MIN. 4.5", MAX 14"	NEW
GENERATOR	GRADE	1915	MIN. 6.0", MAX 13"	NEW
TOTAL		2235		

0 1/2 1  
IF THIS BAR DOES NOT MEASURE 1" THEN DRAWING IS NOT TO FULL SCALE

No.	Date	Revisions
3	04-10-25	ADDENDUM NO. 3
0	02-18-25	RFP SET



Drawn by WM  
Checked by JH/ERF  
Project No. 40034G  
Scale AS SHOWN  
Date 02/18/2025

**GREENMAN PEDERSEN, INC**  
2 EXECUTIVE BOULEVARD  
SUITE 202  
SPRINGFIELD, NJ 07081  
Mechanical, Electrical & Structural Engineer

**ATZL NASHER, & ZIGLER**  
254 North Main Street  
New City, NY 10956  
Civil Engineer

**RENOVATION OF ROCKLAND GREEN ADMINISTRATIVE HEADQUARTERS AND CONSTRUCTION OF AN IMMERSIVE THEATRE EXPERIENCE**  
172 MAIN STREET  
NAUSETT, NY 10964  
TOWN OF CLANSTON, COUNTY OF ROCKLAND



© COPYRIGHT, MICHAEL SHILALE ARCHITECTS, ALL RIGHTS RESERVED.  
Drawing Title  
**PLUMBING SITE PLAN**

Drawing No.  
**P002**



INDOOR VRF UNIT SCHEDULE

UNIT TAG	ROOM #	ROOM NAME	CONFIGURATION	TOTAL SUPPLY AIRFLOW (CFM)	REQUIRED (BTU/H)		CAPACITY (BTU/H)		REFRIGERANT	REFR. SAFETY CLASS	V/PH/HZ	POWER COOLING (KW)	POWER HEATING (KW)	MCA / MFS	UNIT WEIGHT LBS	UNIT DIMENSIONS (LxW, IN)	UNIT DEPTH (IN)	BASIS OF DESIGN		REMARKS
					COOLING	HEATING	COOLING	HEATING										MFGR	MODEL	
AC 1-01	2003	OPEN OFFICE	CEILING-CASSETTE (FOUR WAY)	280	2,760	1,470	4,648.3	4,407.4	R410A	A1	208/1/60	0.02	0.02	0.24/15	28.9	22-7/16x22-7/16	8-3/16	TRANE	TPLFYP005FM140B	SEE NOTES
AC 1-02	2003	OPEN OFFICE	CEILING-CASSETTE (FOUR WAY)	280	2,760	1,470	4,648.3	4,407.4	R410A	A1	208/1/60	0.02	0.02	0.24/15	28.9	22-7/16x22-7/16	8-3/16	TRANE	TPLFYP005FM140B	SEE NOTES
AC 1-03	2016	STORAGE	CEILING-CASSETTE (FOUR WAY)	280	1,080	330	4,648.3	4,407.4	R410A	A1	208/1/60	0.02	0.02	0.24/15	28.9	22-7/16x22-7/16	8-3/16	TRANE	TPLFYP005FM140B	SEE NOTES
AC 1-04	2019	CORRIDOR	CEILING-CASSETTE (FOUR WAY)	280	2,280	1,570	4,648.3	4,407.4	R410A	A1	208/1/60	0.02	0.02	0.24/15	28.9	22-7/16x22-7/16	8-3/16	TRANE	TPLFYP005FM140B	SEE NOTES
AC 1-05	2001	OFFICE	CEILING-CASSETTE (FOUR WAY)	335	2,400	870	11,155.9	10,625.0	R410A	A1	208/1/60	0.02	0.02	0.29/15	31.3	22-7/16x22-7/16	8-3/16	TRANE	TPLFYP012FM140B	SEE NOTES
AC 1-06	2010	BREAK ROOM	CEILING-CASSETTE (FOUR WAY)	297	9,720	2,440	11,155.9	10,625.0	R410A	A1	208/1/60	0.04	0.03	0.24/15	31.3	22-7/16x22-7/16	8-3/16	TRANE	TPLFYP012FM140B	SEE NOTES
AC 1-07	2010	BREAK ROOM	CEILING-CASSETTE (FOUR WAY)	297	9,720	2,440	11,155.9	10,625.0	R410A	A1	208/1/60	0.04	0.03	0.24/15	31.3	22-7/16x22-7/16	8-3/16	TRANE	TPLFYP012FM140B	SEE NOTES
AC 1-08	2018	CORRIDOR	CEILING-CASSETTE (FOUR WAY)	280	2,280	1,570	4,648.3	4,407.4	R410A	A1	208/1/60	0.02	0.02	0.24/15	28.9	22-7/16x22-7/16	8-3/16	TRANE	TPLFYP005FM140B	SEE NOTES
AC 1-09	2011	THEATER	CEILING-CASSETTE (ONE WAY)	328	11,155	4,490	13,400.0	12,800.0	R410A	A1	208/1/60	0.02	0.02	0.29/15	31.3	31-31/32x15-9/16	9-1/16	TRANE	TPMFYP015BM140F	SEE NOTES
AC 1-10	2011	THEATER	CEILING-CASSETTE (ONE WAY)	328	11,155	4,490	13,400.0	12,800.0	R410A	A1	208/1/60	0.02	0.02	0.29/15	31.3	31-31/32x15-9/16	9-1/16	TRANE	TPMFYP015BM140F	SEE NOTES
AC 1-11	2000	ENTRANCE LOBBY	CEILING-CASSETTE (ONE WAY)	328	4,000	3,140	7,240.4	6,954.0	R410A	A1	208/1/60	0.02	0.02	0.29/15	31.3	31-31/32x15-9/16	9-1/16	TRANE	TPMFYP008BM140F	SEE NOTES
AC 1-12	2008	EDUCATIONAL EXHIBIT	CEILING-CASSETTE (ONE WAY)	328	6,352	3,017	11,155.9	6,954.4	R410A	A1	208/1/60	0.02	0.02	0.29/15	31.3	31-31/32x15-9/16	9-1/16	TRANE	TPMFYP012BM140F	SEE NOTES
AC 1-13	2008	EDUCATIONAL EXHIBIT	CEILING-CASSETTE (ONE WAY)	328	6,352	3,017	11,155.9	10,625.0	R410A	A1	208/1/60	0.02	0.02	0.29/15	31.3	31-31/32x15-9/16	9-1/16	TRANE	TPMFYP012BM140F	SEE NOTES
AC 1-14	2008	EDUCATIONAL EXHIBIT	CEILING-CASSETTE (ONE WAY)	328	6,352	3,017	7,240.4	6,954.4	R410A	A1	208/1/60	0.02	0.02	0.29/15	31.3	31-31/32x15-9/16	9-1/16	TRANE	TPMFYP008BM140F	SEE NOTES
AC 2-01	200	RECEPTION	CEILING-CASSETTE (FOUR WAY)	315	3,240	2,300	7,240.4	6,954.4	R410A	A1	208/1/60	0.02	0.02	0.28/15	31.3	22-7/16x22-7/16	8-3/16	TRANE	TPLFYP008FM140B	SEE NOTES
AC 2-02	210	OFFICE	CEILING-CASSETTE (FOUR WAY)	280	3,000	1,150	4,525.3	4,327.2	R410A	A1	208/1/60	0.02	0.02	0.24/15	28.9	22-7/16x22-7/16	8-3/16	TRANE	TPLFYP005FM140B	SEE NOTES
AC 2-03	209	OFFICE	CEILING-CASSETTE (FOUR WAY)	280	2,760	1,140	4,525.3	4,327.2	R410A	A1	208/1/60	0.02	0.02	0.24/15	28.9	22-7/16x22-7/16	8-3/16	TRANE	TPLFYP005FM140B	SEE NOTES
AC 2-04	208	OFFICE	CEILING-CASSETTE (FOUR WAY)	280	2,880	1,200	4,525.3	4,327.2	R410A	A1	208/1/60	0.02	0.02	0.24/15	28.9	22-7/16x22-7/16	8-3/16	TRANE	TPLFYP005FM140B	SEE NOTES
AC 2-05	207	OFFICE	CEILING-CASSETTE (FOUR WAY)	335	6,600	3,440	10,860.7	10,431.6	R410A	A1	208/1/60	0.02	0.02	0.24/15	31.3	22-7/16x22-7/16	8-3/16	TRANE	TPLFYP012FM140B	SEE NOTES
AC 2-06	215	KITCHENETTE	CEILING-CASSETTE (FOUR WAY)	280	2,117	1,044	4,525.3	4,327.2	R410A	A1	208/1/60	0.02	0.02	0.24/15	28.9	22-7/16x22-7/16	8-3/16	TRANE	TPLFYP005FM140B	SEE NOTES
AC 2-07	201	OPEN OFFICE	CEILING-CASSETTE (FOUR WAY)	280	2,117	1,044	4,525.3	4,327.2	R410A	A1	208/1/60	0.02	0.02	0.24/15	28.9	22-7/16x22-7/16	8-3/16	TRANE	TPLFYP005FM140B	SEE NOTES
AC 2-08	202	OFFICE	CEILING-CASSETTE (FOUR WAY)	280	2,160	1,180	4,525.3	4,327.2	R410A	A1	208/1/60	0.02	0.02	0.24/15	28.9	22-7/16x22-7/16	8-3/16	TRANE	TPLFYP005FM140B	SEE NOTES
AC 2-09	201	OPEN OFFICE	CEILING-CASSETTE (FOUR WAY)	280	2,117	1,044	4,525.3	4,327.2	R410A	A1	208/1/60	0.02	0.02	0.24/15	28.9	22-7/16x22-7/16	8-3/16	TRANE	TPLFYP005FM140B	SEE NOTES
AC 2-10	201	OPEN OFFICE	CEILING-CASSETTE (FOUR WAY)	280	2,117	1,044	4,525.3	4,327.2	R410A	A1	208/1/60	0.02	0.02	0.24/15	28.9	22-7/16x22-7/16	8-3/16	TRANE	TPLFYP005FM140B	SEE NOTES
AC 2-11	205	OFFICE	CEILING-CASSETTE (FOUR WAY)	335	5,640	2,480	10,860.7	10,431.6	R410A	A1	208/1/60	0.02	0.02	0.29/15	31.3	22-7/16x22-7/16	8-3/16	TRANE	TPLFYP012FM140B	SEE NOTES
AC 2-12	204	OFFICE	CEILING-CASSETTE (FOUR WAY)	280	3,360	1,820	4,525.3	4,327.7	R410A	A1	208/1/60	0.02	0.02	0.24/15	28.9	22-7/16x22-7/16	8-3/16	TRANE	TPLFYP005FM140B	SEE NOTES
AC 2-13	203	OFFICE	CEILING-CASSETTE (FOUR WAY)	280	2,160	1,060	4,525.3	4,327.7	R410A	A1	208/1/60	0.02	0.02	0.24/15	28.9	22-7/16x22-7/16	8-3/16	TRANE	TPLFYP005FM140B	SEE NOTES
AC 2-14	214	CONFERENCE ROOM	CEILING-CASSETTE (FOUR WAY)	460	6,360	3,400	16,291.0	15,454.2	R410A	A1	208/1/60	0.04	0.04	0.5/15	31.1	22-7/16x22-7/16	8-3/16	TRANE	TPLFYP018FM140B	SEE NOTES
AC 2-15	214	CONFERENCE ROOM	CEILING-CASSETTE (FOUR WAY)	460	6,360	3,400	16,291.0	15,454.2	R410A	A1	208/1/60	0.04	0.04	0.5/15	31.1	22-7/16x22-7/16	8-3/16	TRANE	TPLFYP018FM140B	SEE NOTES
AC 2-16	214	CONFERENCE ROOM	CEILING-CASSETTE (FOUR WAY)	460	6,360	3,400	16,291.0	15,454.2	R410A	A1	208/1/60	0.04	0.04	0.5/15	31.1	22-7/16x22-7/16	8-3/16	TRANE	TPLFYP018FM140B	SEE NOTES

- INDOOR VRF UNIT SCHEDULE NOTES:**
- NOMINAL COOLING CAPACITIES ARE BASED ON INDOOR COIL EAT OF 80/67°F (DB/WB), OUTDOOR OF 95°F (DB)
  - NOMINAL HEATING CAPACITIES ARE BASED ON INDOOR COIL EAT OF 70°F (DB), OUTDOOR OF 43°F (WB) SEE OUTDOOR UNIT SCHEDULE FOR OUTDOOR AMBIENT CONDITIONS, CONNECTED CAPACITY, AND OTHER FACTORS ASSOCIATED WITH CORRECTED CAPACITIES
  - CONTRACTOR RESPONSIBLE TO FIELD VERIFY ALL PIPE LENGTHS AND COORDINATE AS-BUILT CONDITION WITH MANUFACTURER TO OBTAIN ALL LOAD CAPACITIES.
  - SEE SCHEMATIC PIPING/CONTROL DIAGRAM FOR INDICATION OF REQUIRED INDOOR UNIT REMOTE CONTROLLERS, SYSTEM CONTROLLERS, AND INTEGRATION DEVICES.
  - PROVIDE CN-24 RELAY KITS FOR ALL INDOOR UNITS FOR INTEGRATION WITH BACK-UP HEAT.
  - PROVIDE TE-200A CENTRALIZED CONTROLLER AND REQUIRED LICENSES OF TRACER SC+ FOR ASSOCIATED CONTROLS.
  - LOCAL CONTROLLERS ARE "SIMPLE" TYPE. LOCAL CONTROLLERS CAN BE MINIMIZED BY PAIRING INDOOR UNITS IN THE SAME ROOM TOGETHER ON A SINGLE LOCAL CONTROLLER, IF DESIRED.
  - FULL DEMAND CORRECTED CAPACITY INCLUDES DE-RATE ASSOCIATED WITH INDOOR VS. OUTDOOR CONNECTED CAPACITY INDICATED ON OUTDOOR UNIT SCHEDULE FOR ASSOCIATED SYSTEM. PARTIAL CORRECTED CAPACITY ASSUMES SUFFICIENT DIVERSITY EXISTS SUCH THAT THE CONNECTED CAPACITY DE-RATE DOES NOT APPLY.
  - REFER TO SPECIFICATION SECTION 238129 FOR ADDITIONAL INFORMATION.

OUTDOOR VRF UNIT SCHEDULE

UNIT TAG	LOCATION	MODULE	COOLING EFFICIENCY (EER/SEER)	CAPACITY (BTU/H)		REFRIGERANT	REFR. SAFETY CLASS	V/PH/HZ	MCA	MOP	UNIT WEIGHT LBS	UNIT DIMENSIONS (LxWxH, IN)	BASIS OF DESIGN		REMARKS
				COOLING	HEATING								MFGR	MODEL	
ACCU-1	ROOF	EP120	22.35/10.5	123,645.0	117,661.7	R410A	A1	208/3/60	56	90	622	48-7/8 x 29-3/16 x 71-5/8	TRANE	TURVE1203AN41AN	SEE NOTES
ACCU-2	ROOF	EP120	22.35/10.5	123,087.5	117,451.6	R410A	A1	208/3/60	56	90	622	48-7/8 x 29-3/16 x 71-5/8	TRANE	TURVE1203AN41AN	SEE NOTES

- OUTDOOR VRF UNIT SCHEDULE NOTES:**
- NOMINAL COOLING CAPACITIES ARE BASED ON INDOOR COIL EAT OF 80/67°F (DB/WB), OUTDOOR OF 95°F (DB)
  - NOMINAL HEATING CAPACITIES ARE BASED ON INDOOR COIL EAT OF 70°F (DB), OUTDOOR OF 43°F (WB)
  - EFFICIENCY VALUES FOR EER, SEER, COP ARE BASED ON AHR1 1230 TEST METHOD FOR MIXTURE OF DUCTED & NON-DUCTED INDOOR UNITS.
  - FOR SYSTEMS WITH MULTIPLE MODULES, REFRIGERANT PIPE DIMENSIONS INDICATE TOTAL SYSTEM COMBINED PIPING DOWNSTREAM OF MODULE TWINNING.
  - ADDED FIELD CHARGE LISTED IS IN ADDITION TO FACTORY CHARGE. THIS MUST BE UPDATED BASED UPON FINAL AS-BUILT PIPING LAYOUT.
  - FACTORY REPRESENTATIVES SHALL REVIEW THE PROJECT PRIOR TO AND THROUGHOUT THE INSTALLATION OF CITY MULTI EQUIPMENT.
  - FACTORY REPRESENTATIVES SHALL STARTUP AND COMMISSION CITY MULTI EQUIPMENT UPON COMPLETION OF EQUIPMENT INSTALLATIONS.
  - FACTORY REPRESENTATIVES SHALL PROVIDE ON-SITE ASSISTANCE FOR THE BMS INTEGRATION OF THE CITY MULTI EQUIPMENT. SEE DRAWING M401 AND M402 FOR ADDITIONAL INFORMATION.
  - FACTORY REPRESENTATIVES SHALL PROVIDE END-USER TRAINING ON THE CITY MULTI EQUIPMENT UPON COMPLETION OF THE INSTALLATION OF EQUIPMENT.
  - REFER TO SPECIFICATION SECTION 238129 FOR ADDITIONAL INFORMATION.

VRF HEAT RECOVERY BRANCH CIRCUIT CONTROLLER

UNIT TAG	LOCATION	REFRIGERANT	TYPE	NUMBER OF PORTS	CONNECTED CAPACITY TO BC	VOLTAGE/PHASE/HZ	MCA	MODEL #	NOTES
BC-1	FIRST FLOOR	R410A	SINGLE	16	133,000.0	208/3/60	1.47	TCMBG1016SJ21N4	SEE NOTES
BC-2	SECOND FLOOR	R410A	SINGLE	16	136,000.0	208/3/60	1.57	TCMBM1016JA21N4	SEE NOTES

- VRF HEAT RECOVERY BRANCH CIRCUIT CONTROLLER SCHEDULE NOTES:**
- INCLUDE DIAMONDBACK BALL VALVES BV-SERIES, 700PSIG WORKING PRESSURE, FULL PORT, 410A RATED.
  - REFER TO SPECIFICATION SECTION 238129 FOR ADDITIONAL INFORMATION.

ADDENDUM NO. 3	04-10-25	DATE
REVISIONS	02-18-25	DATE
NO.	0	NO.

Drawn by	WM/AW
Checked by	PC/ERF
Project No.	40034C
Scale	AS SHOWN
Date	02/18/2025

**GREENMAN PEDERSEN, INC.**  
 Mechanical, Electrical, Structural Engineer  
 200 North Main Street  
 Summit, NJ 07901

**ATZL NASHER & ZIGLER**  
 Civil Engineer  
 204 North Main Street  
 Summit, NJ 07905

**RENOVATION OF ROCKLAND GREEN ADMINISTRATIVE HEADQUARTERS AND CONSTRUCTION OF AN IMMERSIVE THEATRE EXPERIENCE**

172 MAIN STREET  
 MAUNTON, NY 10854


TOWN OF ROCKLAND  
 COUNTY OF ROCKLAND

**MSA**  
 MICHAEL SHILALE ARCHITECTS, LLP  
 140 Park Avenue New City, NY 10956 Tel 845-708-9200  
 www.shilale.com

Copyright, Michael Shilale Architects, All Rights Reserved.


Drawing Title  
**MECHANICAL SCHEDULES - 2**

Drawing No.  
**M003**

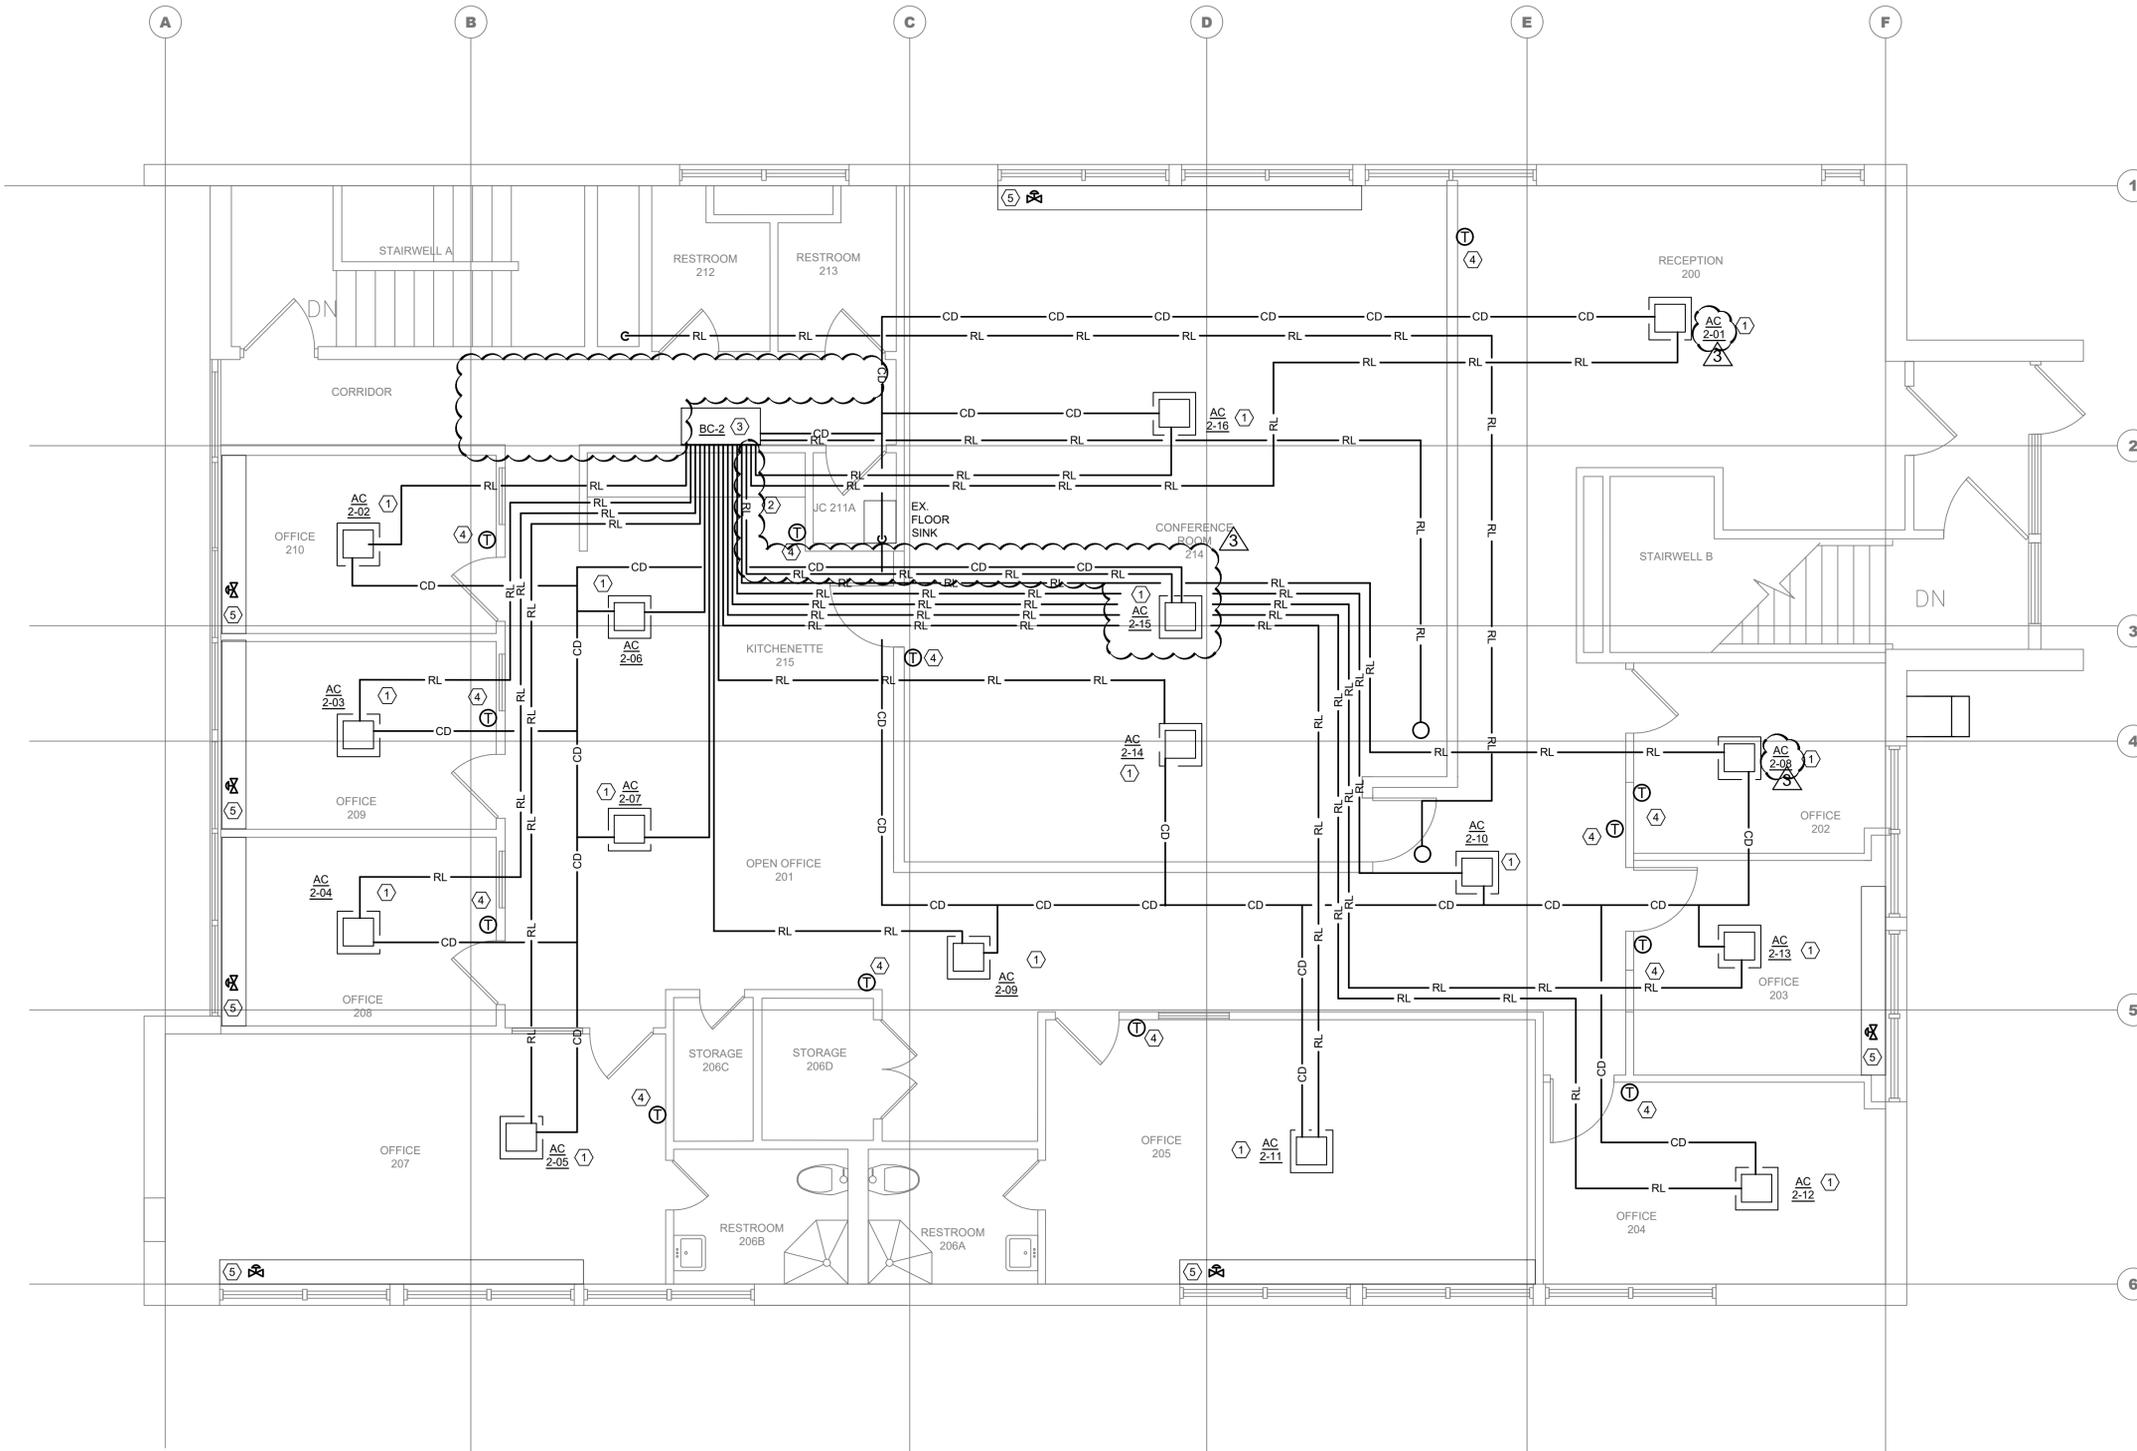

- KEYED NOTES:**
- 1 PROVIDE INDOOR VRF CEILING CASSETTE UNIT INCLUDING HANGERS AND SUPPORTS. REFER TO VRF INDOOR UNIT SCHEDULE ON DRAWING M003. REFER TO MANUFACTURER FOR INSTALLATION DETAILS. REFER TO DIVISION 23 SPECIFICATIONS FOR ADDITIONAL INFORMATION.
  - 2 PROVIDE REFRIGERANT LIQUID/SUCTION PIPING, CONDENSATE DRAIN PIPING AND INSULATION FOR EACH INDOOR UNIT INCLUDING HANGERS AND SUPPORTS. SEE MANUFACTURER'S IOM MANUAL AND MECHANICAL DETAILS DRAWINGS FOR ADDITIONAL INFORMATION.
  - 3 PROVIDE BRANCH CONTROLLER BOX. REFER TO MANUFACTURER'S IOM MANUAL FOR ADDITIONAL INFORMATION. SEE DRAWING M003 AND SPECIFICATIONS FOR ADDITIONAL INFORMATION.
  - 4 PROVIDE WALL MOUNTED THERMOSTAT FOR CONTROL OF VRF INDOOR UNIT IN EACH SPACE.
  - 5 PROVIDE NEW ZONE VALVE AT EXISTING BASEBOARD HEATER. REFER TO MECHANICAL DETAILS FOR ADDITIONAL INFORMATION. REFER TO SEQUENCE OF OPERATION FOR INTERLOCK OF ZONE VALVE WITH NEW VRF SYSTEM.

- GENERAL NOTES:**
1. CONTRACTOR TO SUBMIT SHOP DRAWING FOR REVIEW AND APPROVAL PRIOR TO PERFORMING THE WORK.
  2. ALL PIPING IS TO BE ROUTED ABOVE CEILING. COORDINATE WORK WITH ALL TRADES.

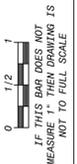

No.	Date	Revisions
3	04-10-25	ADDENDUM NO. 3
0	02-18-25	RFF SET

Drawn by	WM/AW
Checked by	PC/ERF
Project No.	40034G
Scale	AS SHOWN
Date	02/18/2025


<b>GREENMAN PEDERSEN, INC</b> 2 EXECUTIVE BOULEVARD SUITE 202 SPRING, NY 10601	<b>ATZL NASHER, &amp; ZIGLER</b> 224 North Main Street New City, NY 10956
Mechanical, Electrical & Structural Engineer	Civil Engineer

**RENOVATION OF ROCKLAND GREEN ADMINISTRATIVE HEADQUARTERS AND CONSTRUCTION OF AN IMMERSIVE THEATRE EXPERIENCE**  
172 MAIN STREET  
NAUTLET, NY 10964  
TOWN OF CLARINGTON  
COUNTY OF ROCKLAND



© COPYRIGHT, MICHAEL SHILALE ARCHITECTS, ALL RIGHTS RESERVED.  
Drawing Title  
**MECHANICAL SECOND FLOOR PIPING INSTALLATION**  
Drawing No.  
**M102**

1  
M-102  
**MECHANICAL SECOND FLOOR PLAN - PIPING**  
SCALE: 1/4" = 1'-0"  
PLAN NORTH

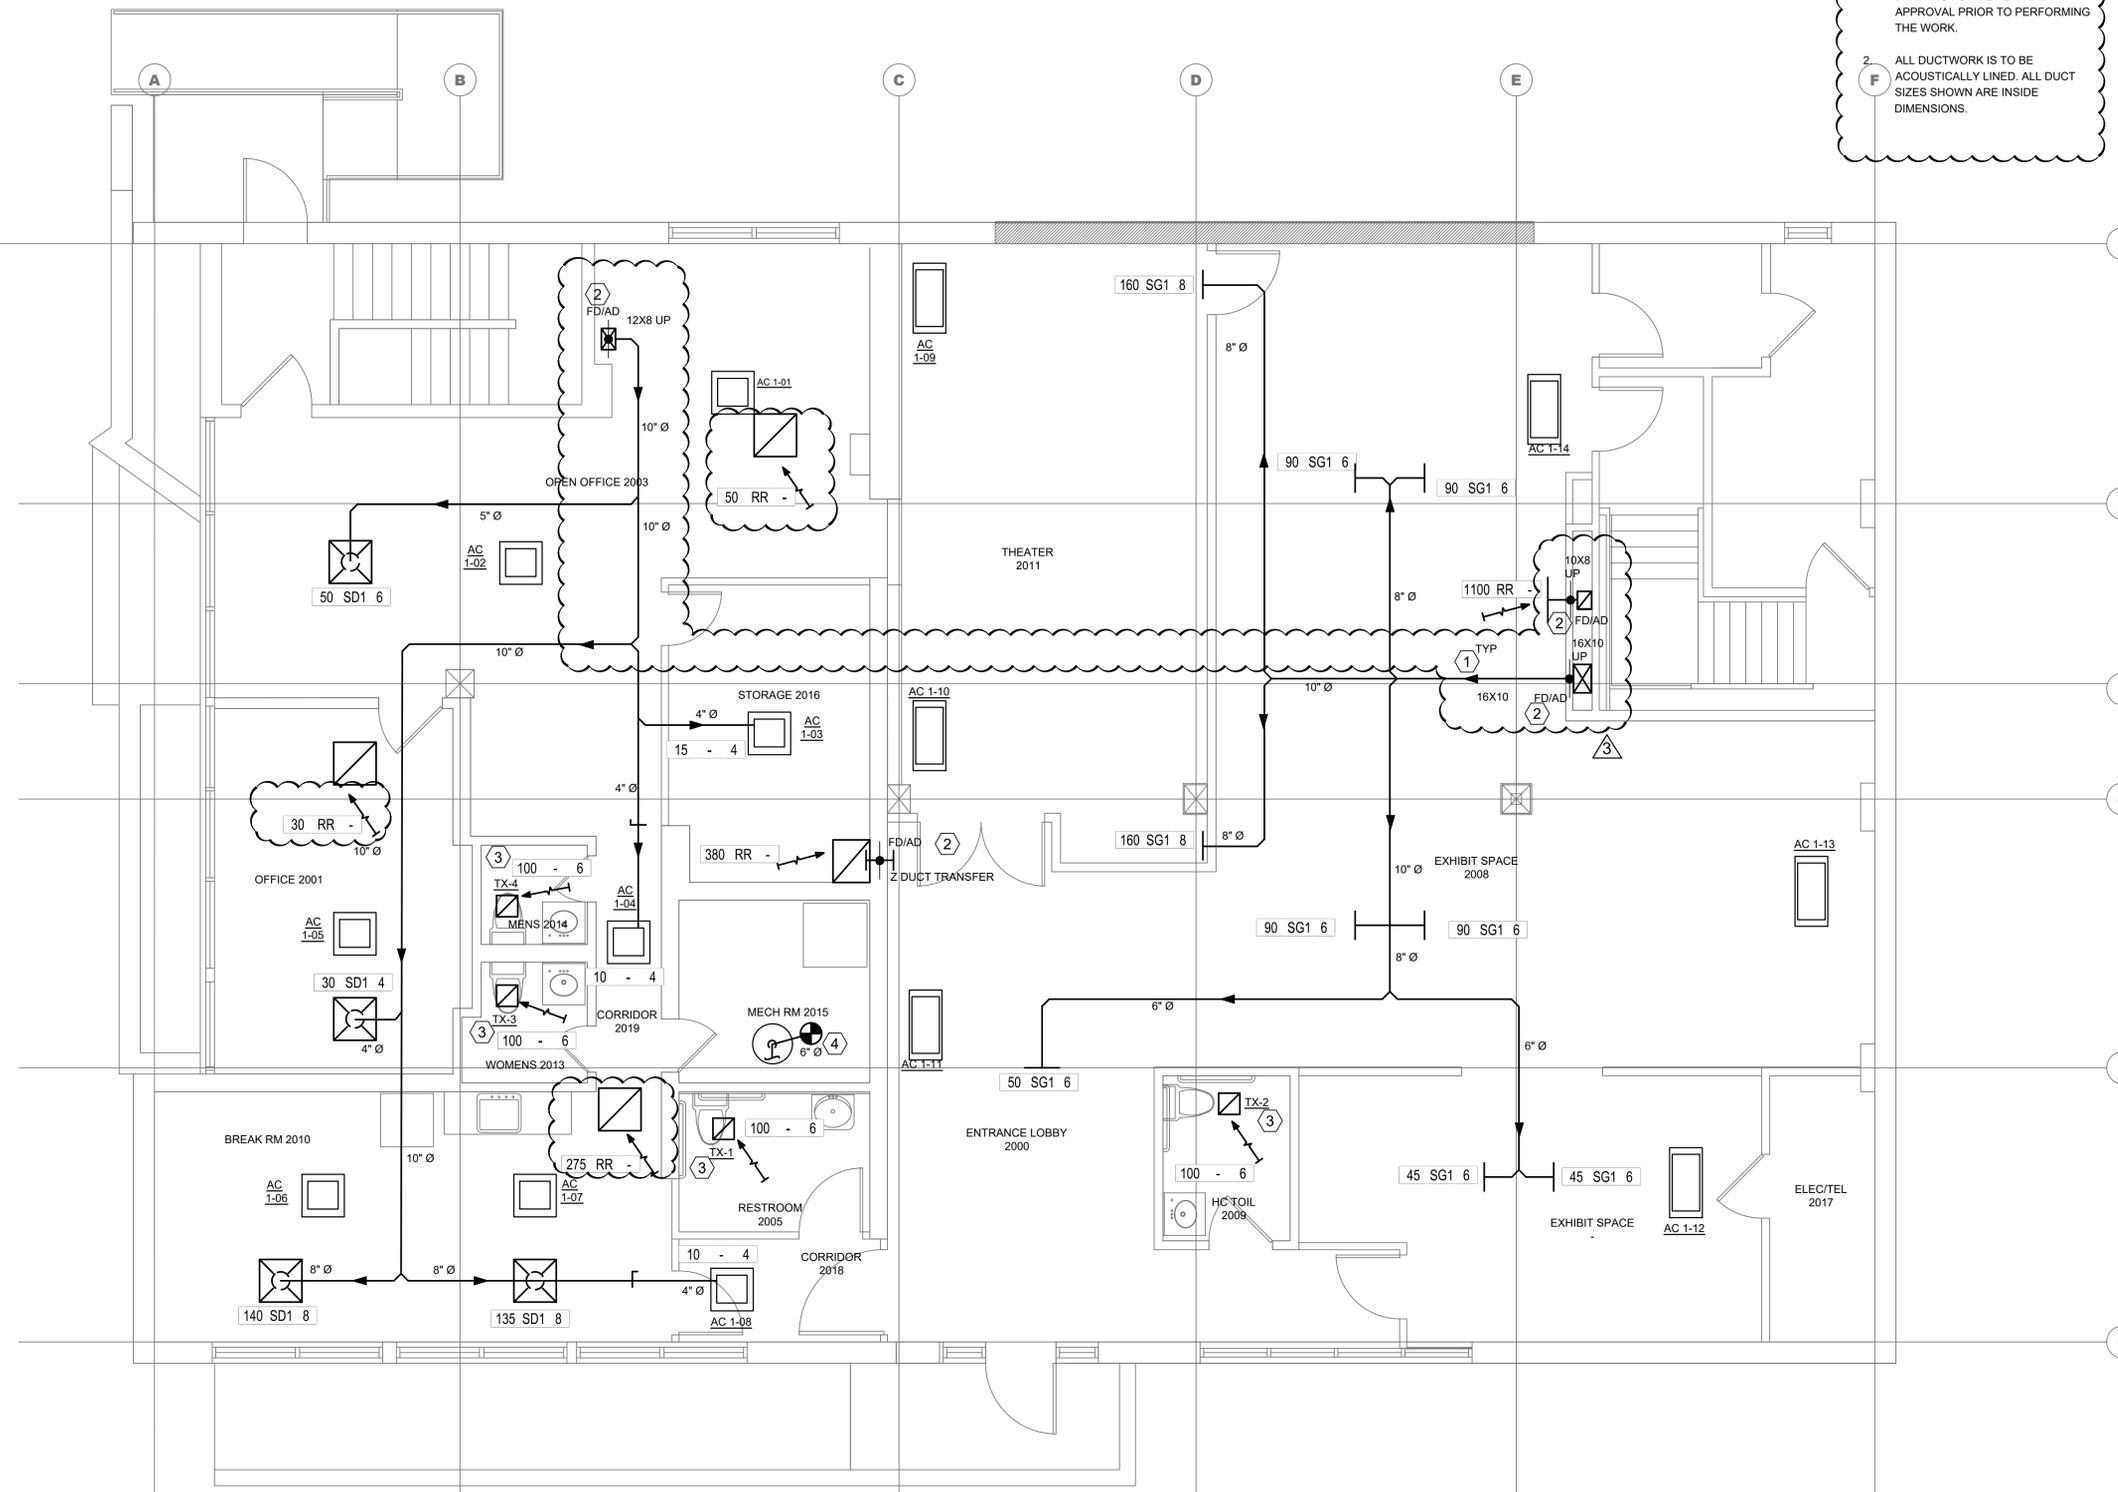


**GENERAL NOTES:**

- CONTRACTOR TO SUBMIT SHOP DRAWING FOR REVIEW AND APPROVAL PRIOR TO PERFORMING THE WORK.
- ALL DUCTWORK IS TO BE ACOUSTICALLY LINED. ALL DUCT SIZES SHOWN ARE INSIDE DIMENSIONS.

**KEYED NOTES:**

- PROVIDE METAL DUCTWORK, INSULATION, HANGERS/SUPPORTS AND AIR INLETS/OUTLETS AS SHOWN. FOR SIZES, SEE FLOOR PLANS AND SCHEDULE ON M004. REFER TO DIVISION 23 SPECIFICATIONS FOR ADDITIONAL INFORMATION.
- FOR DUCTWORK PENETRATIONS THROUGH FIRE RATED ASSEMBLIES, SEE MECHANICAL DETAILS DRAWINGS.
- PROVIDE NEW TOILET EXHAUST FAN, SEE FAN SCHEDULE ON M004. CONNECT EXHAUST DUCTWORK TO EXISTING VENT UP TO ROOF. REFER TO DIVISION 23 SPECIFICATIONS FOR ADDITIONAL INFORMATION.
- PROVIDE TYPE B FLUE GAS VENT AND SUPPORTS. CONNECT TO EXISTING 10" Ø TYPE B FLUE FOR GAS FIRED DOMESTIC HOT WATER HEATER, COORDINATE WITH PLUMBING.

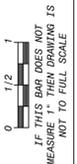

No.	Date	Revisions
3	04-10-25	ADDENDUM NO. 3
0	02-18-25	RFF SET

Drawn by: WM/AW  
 Checked by: PC/ERF  
 Project No.: 40034G  
 Scale: AS SHOWN  
 Date: 02/18/2025

**GREENMAN PEDERSEN, INC.**  
 Mechanical, Electrical, & Structural Engineer  
 200 WEST 30TH STREET, SUITE 202  
 SPRINGFIELD, NY 12151

**ATZL NASHER, & ZIGLER**  
 Civil Engineer  
 254 North Main Street  
 New City, NY 10956

**RENOVATION OF ROCKLAND GREEN ADMINISTRATIVE HEADQUARTERS AND CONSTRUCTION OF AN IMMERSIVE THEATRE EXPERIENCE**

172 MAIN STREET  
 NAUTLET, NY 10964

TOWN OF CLANSTON  
 COUNTY OF ROCKLAND


**MSA**  
 MICHAEL SHILALE ARCHITECTS, LLP  
 140 Park Avenue New City, NY 10956 Tel 845-708-9200  
 www.shilale.com

**M201**

Drawing No.

**MECHANICAL FIRST FLOOR DUCTWORK**  
 SCALE: 1/4" = 1'-0"  
 PLAN NORTH

© COPYRIGHT, MICHAEL SHILALE ARCHITECTS. ALL RIGHTS RESERVED.

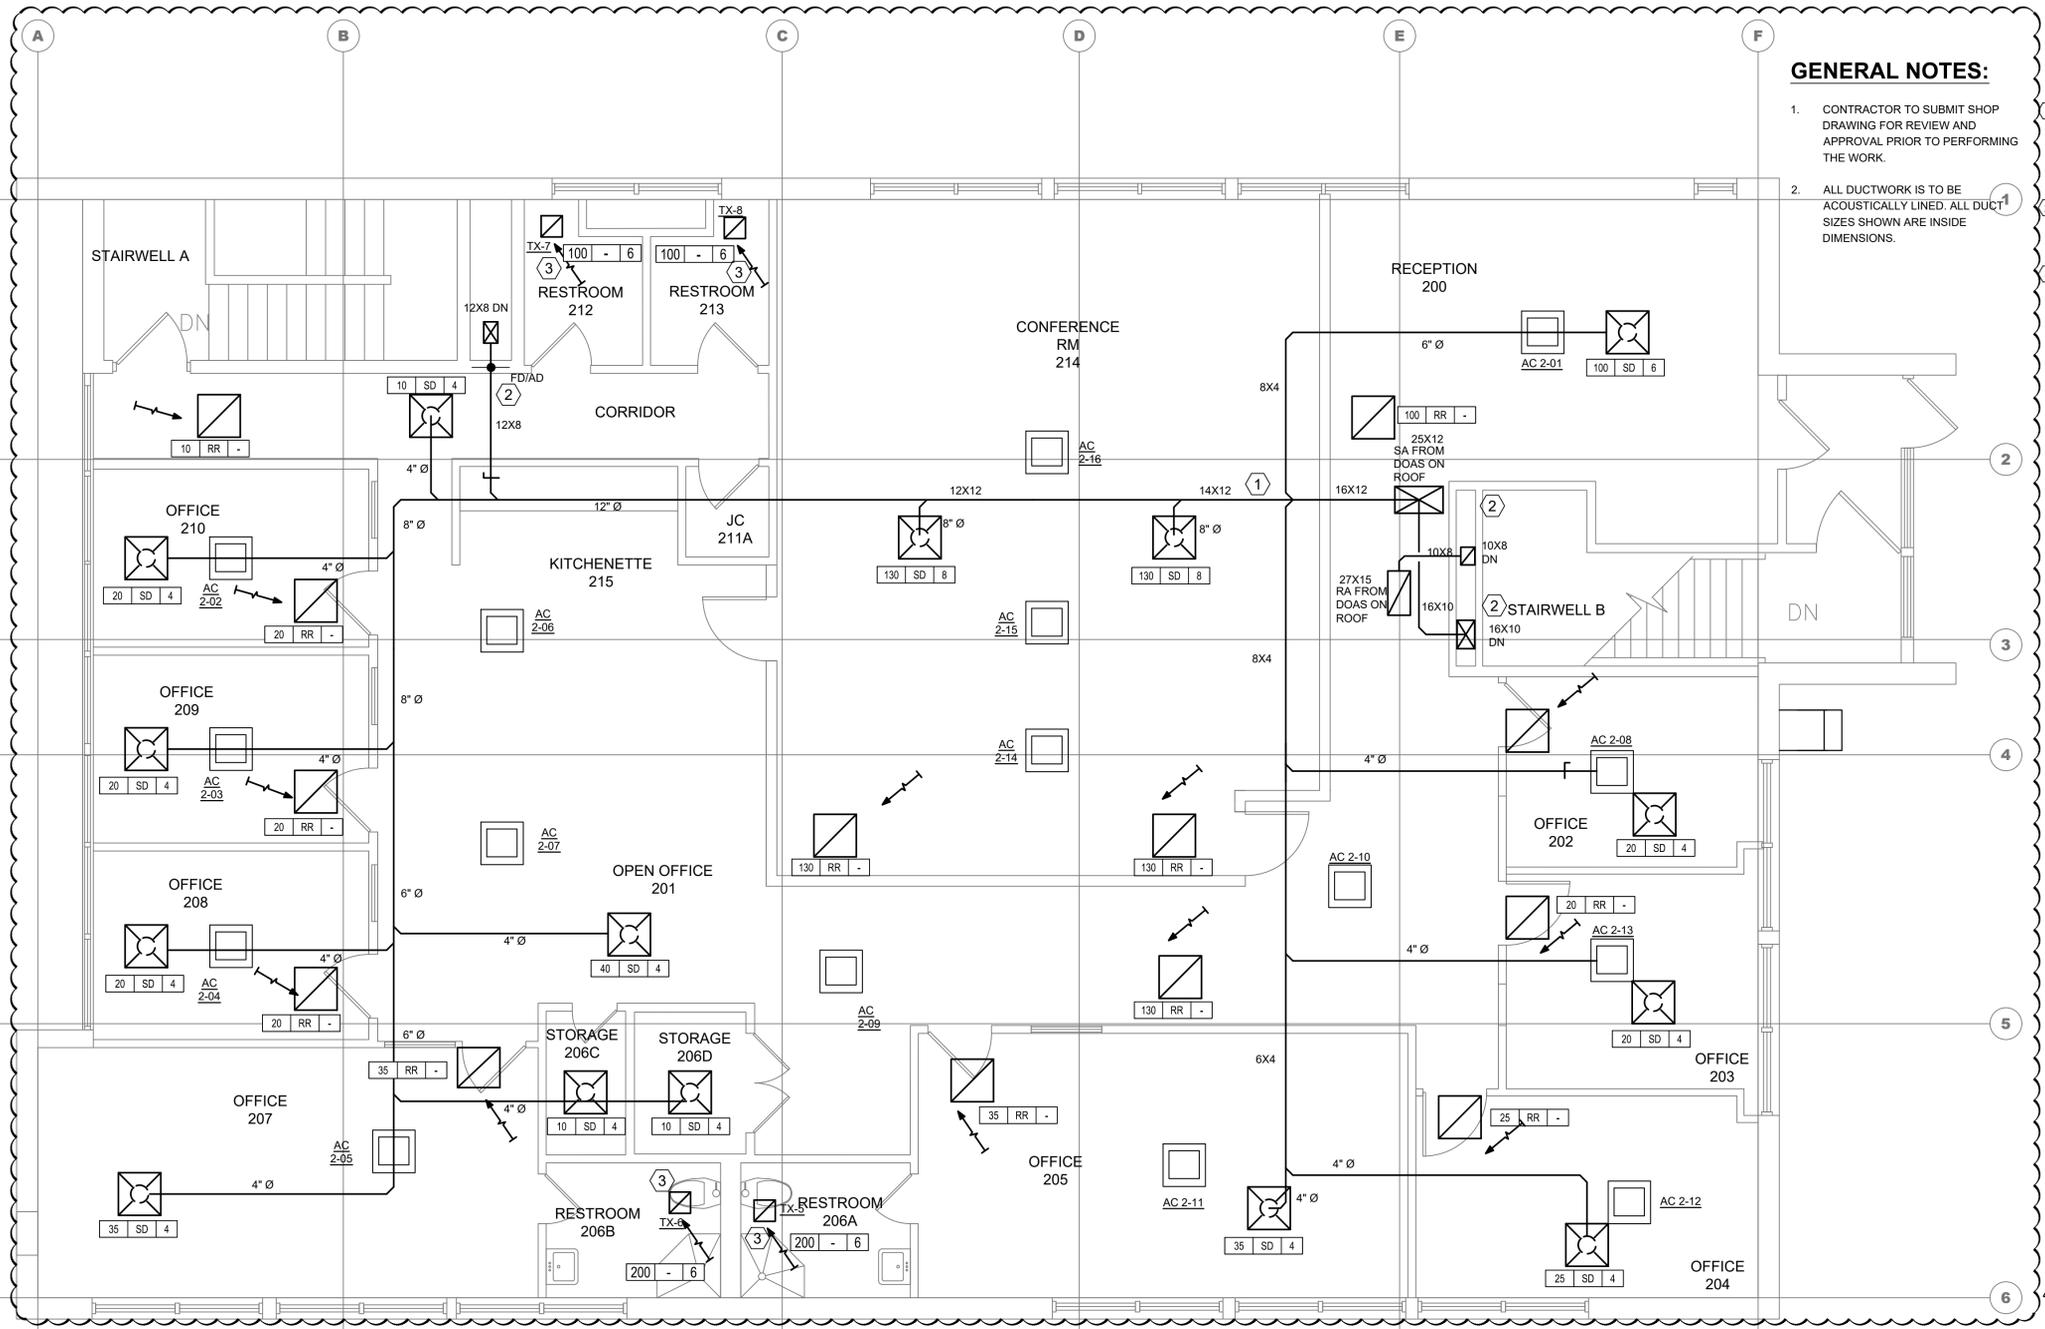


**GENERAL NOTES:**

- CONTRACTOR TO SUBMIT SHOP DRAWING FOR REVIEW AND APPROVAL PRIOR TO PERFORMING THE WORK.
- ALL DUCTWORK IS TO BE ACOUSTICALLY LINED. ALL DUCT SIZES SHOWN ARE INSIDE DIMENSIONS.

**KEYED NOTES:**

- PROVIDE METAL DUCTWORK, INSULATION, HANGERS/SUPPORTS AND AIR INLETS/OUTLETS AS SHOWN. FOR SIZES, SEE FLOOR PLANS AND SCHEDULE ON M004. REFER TO DIVISION 23 SPECIFICATIONS FOR ADDITIONAL INFORMATION.
- FOR DUCTWORK PENETRATIONS THROUGH FIRE RATED ASSEMBLIES, SEE MECHANICAL DETAILS DRAWINGS.
- PROVIDE NEW TOILET EXHAUST FAN. SEE FAN SCHEDULE ON M004. CONNECT EXHAUST DUCTWORK TO EXISTING TO VENT UP TO ROOF. REFER TO DIVISION 23 SPECIFICATIONS FOR ADDITIONAL INFORMATION.

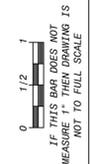

1  
M-202  
MECHANICAL SECOND FLOOR DUCTWORK  
SCALE: 1/4" = 1'-0"



No.	Date	Revisions
3	04-10-25	ADDENDUM NO. 3
0	02-18-25	RFF SET


Drawn by	WM/AW
Checked by	PC/ERF
Project No.	40034G
Scale	AS SHOWN
Date	02/18/2025

<b>GREENMAN PEDERSEN, INC</b> 2 EXECUTIVE BOULEVARD SUITE 202 SPRINGFIELD, NY 10901	<b>ATZL NASHER, &amp; ZIGLER</b> 254 North Main Street New City, NY 10956
Mechanical, Electrical, & Structural Engineer	Civil Engineer


**RENOVATION OF ROCKLAND GREEN ADMINISTRATIVE HEADQUARTERS AND CONSTRUCTION OF AN IMMERSIVE THEATRE EXPERIENCE**  
172 MAIN STREET  
NAUSETT, NY 10964  
TOWN OF ROCKLAND  
COUNTY OF ROCKLAND



© COPYRIGHT, MICHAEL SHILALE ARCHITECTS. ALL RIGHTS RESERVED.  
Drawing Title  
**MECHANICAL SECOND FLOOR DUCTWORK INSTALLATION**  
Drawing No.  
**M202**

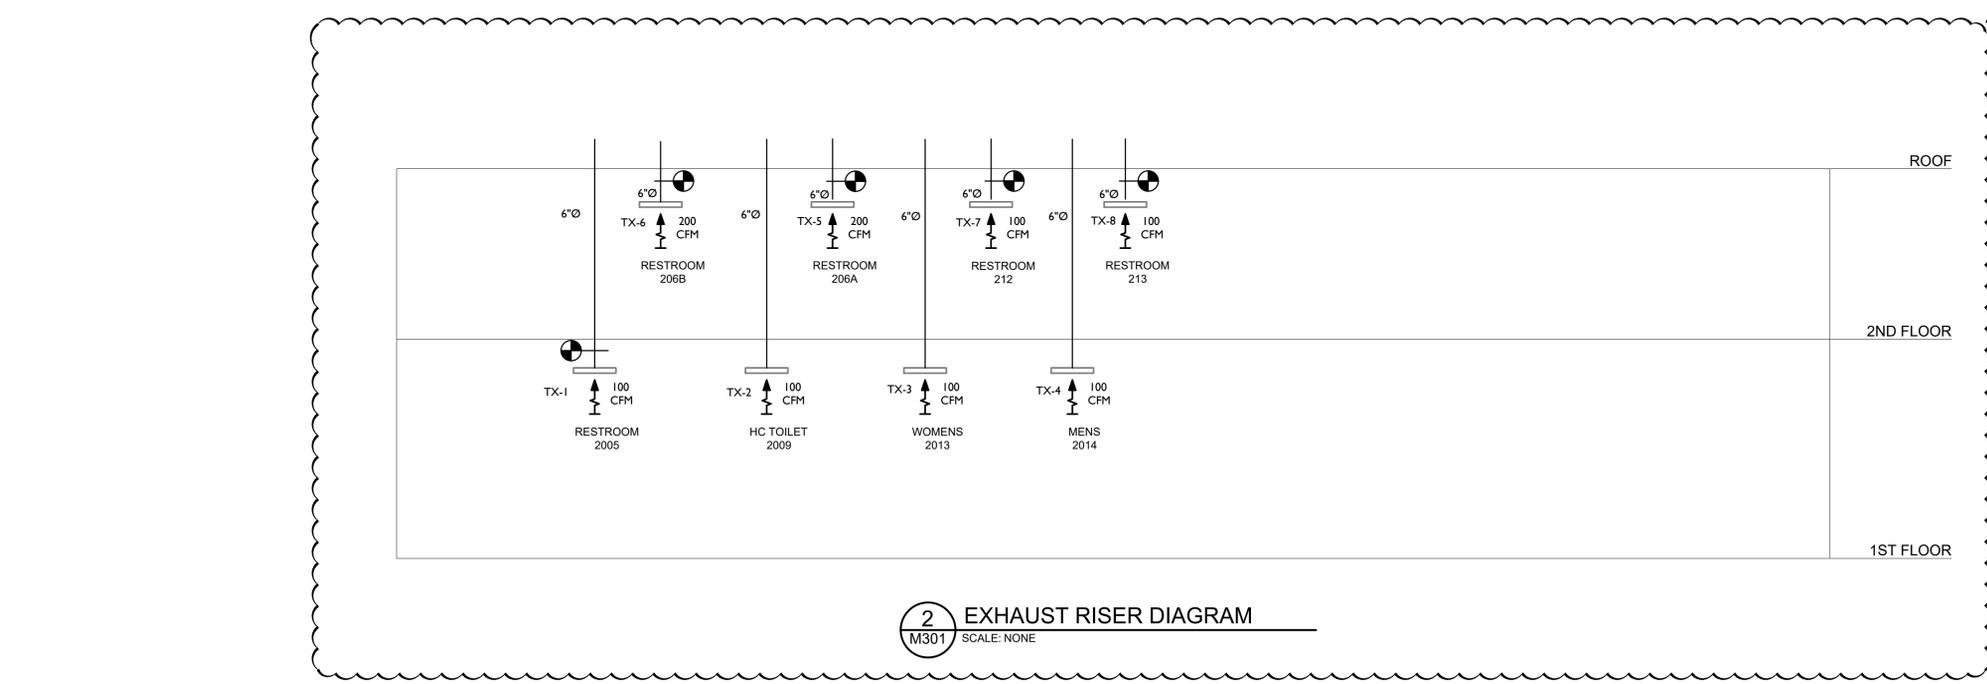

**2** EXHAUST RISER DIAGRAM  
M301 SCALE: NONE

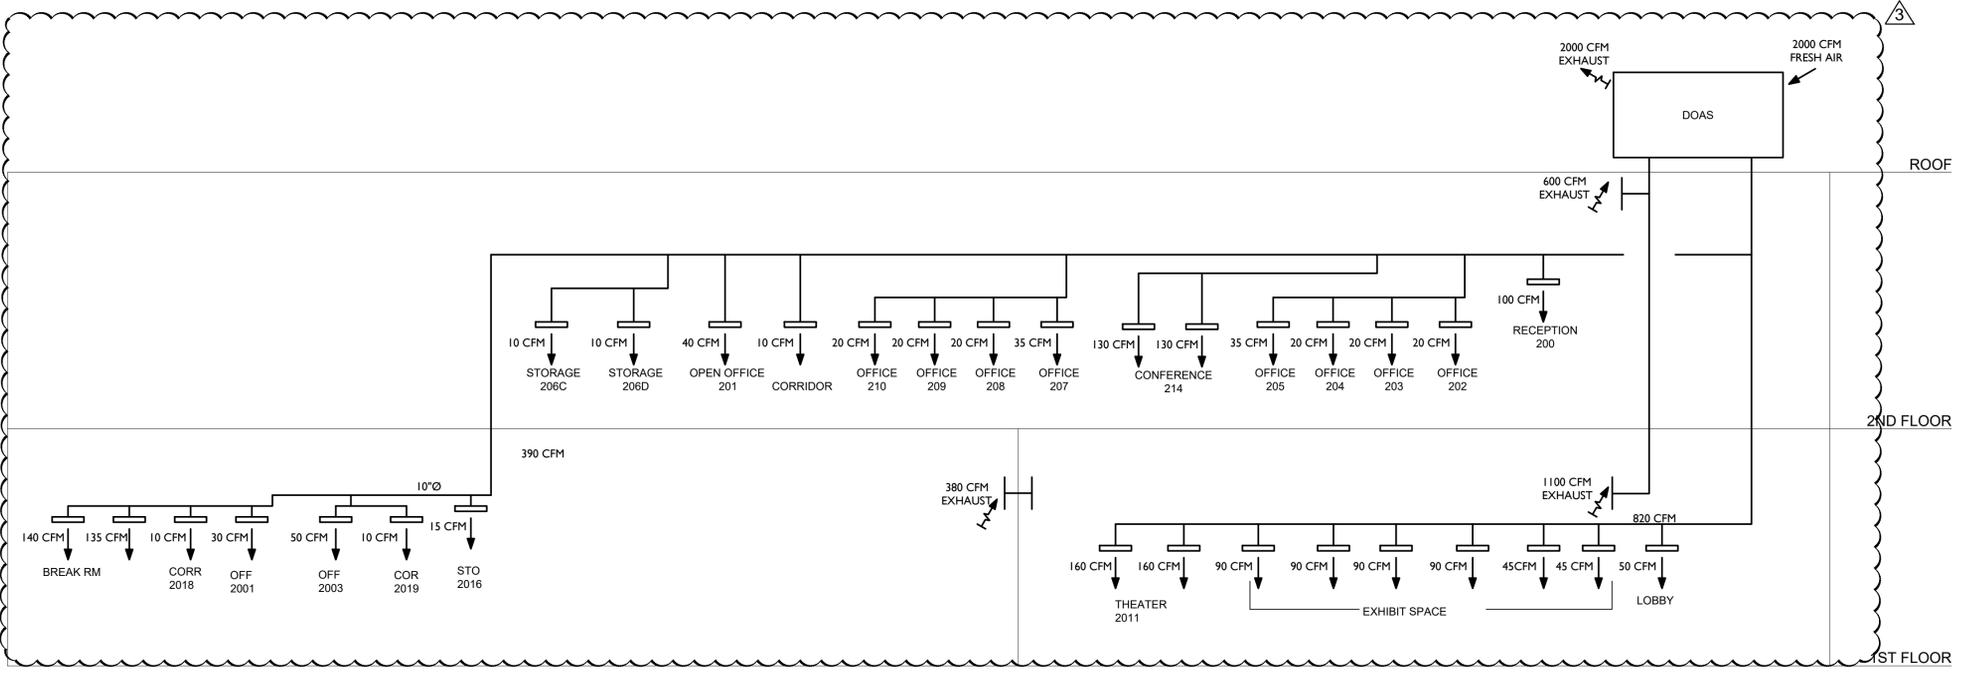

**1** VENTILATION RISER DIAGRAM  
M301 SCALE: NONE

No.	Date	Revisions
3	04-10-25	ADDENDUM NO. 3
0	02-18-25	RFP SET



Drawn by	WM
Checked by	PC
Project No.	40034G
Scale	NONE
Date	02/18/2025

<b>GREENMAN PEDERSEN, INC</b> 2 EXECUTIVE BOULEVARD SUITE 202 SPRINGFIELD, NJ 07081	<b>ATZL NASHER, &amp; ZIGLER</b> 224 North Main Street New City, NY 10956
Mechanical, Electrical, & Structural Engineer	Civil Engineer

RENOVATION OF ROCKLAND GREEN ADMINISTRATIVE HEADQUARTERS AND CONSTRUCTION OF AN IMMERSIVE THEATRE EXPERIENCE  
172 MAIN STREET  
HAUNGETT, NJ 10954  
TOWN OF CLANSTON, COUNTY OF ROCKLAND



© COPYRIGHT, MICHAEL SHILALE ARCHITECTS, ALL RIGHTS RESERVED. Drawing Title <b>AIR RISER DIAGRAM</b>	Drawing No. <b>M301</b>
--	----------------------------

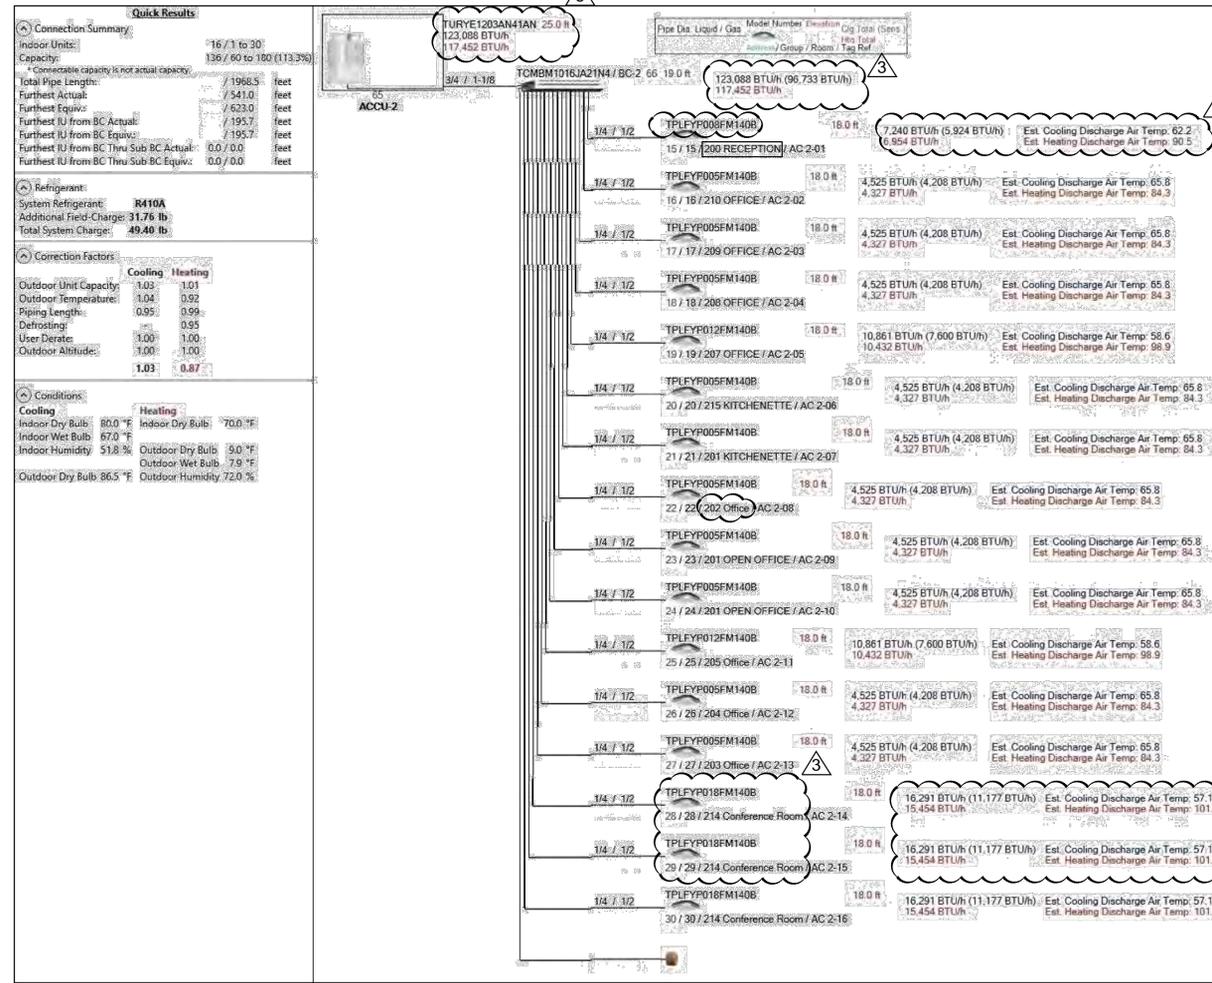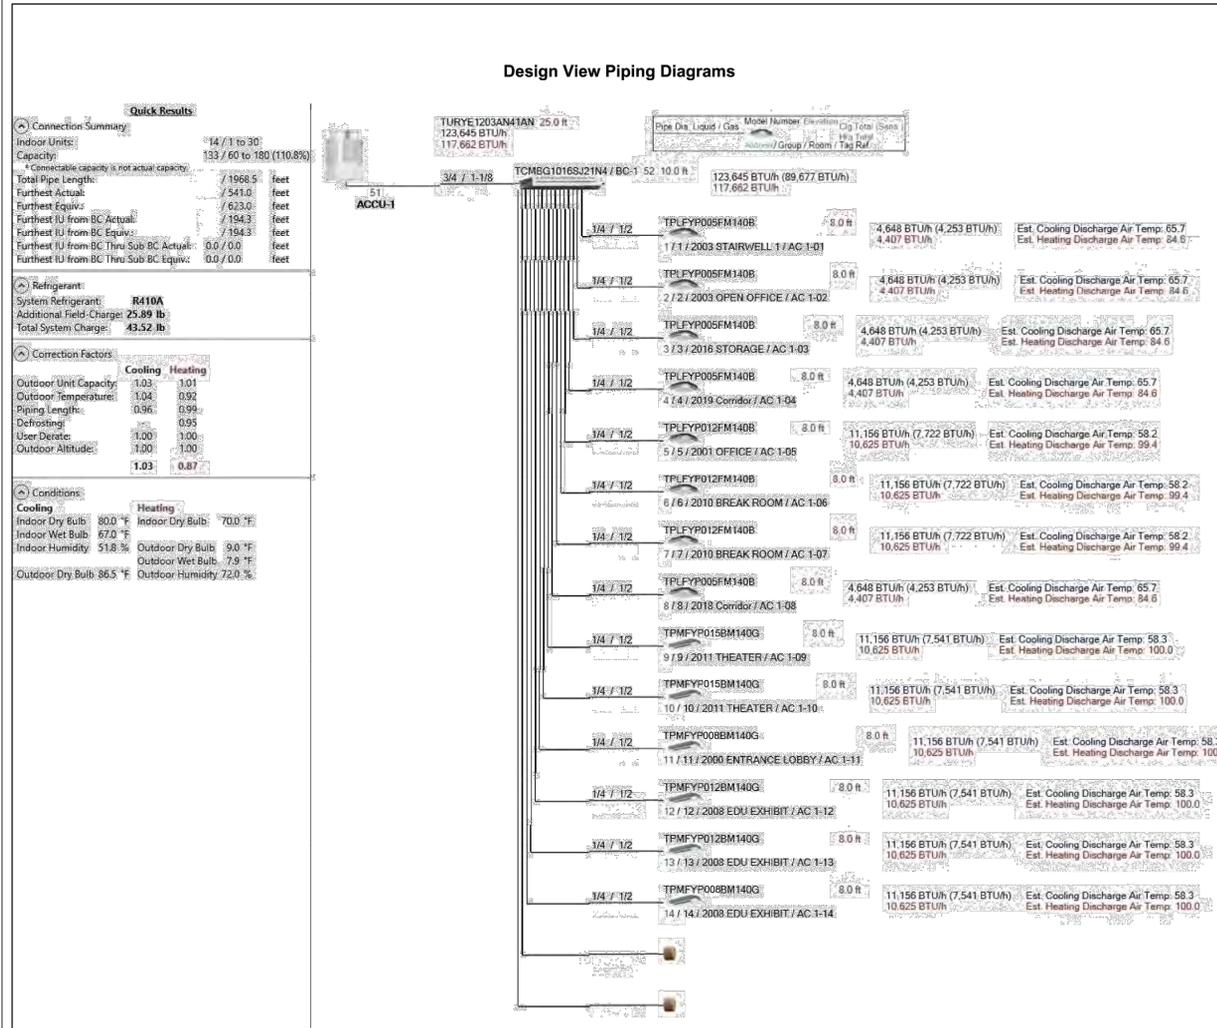

1 VRF PIPING RISER DIAGRAM  
 M302 SCALE: NONE

No.	Date	Revisions
3	04-10-25	ADDENDUM NO. 3
0	02-18-25	RFP SET

Drawn by	WM
Checked by	PC
Project No.	40034C
Scale	NONE
Date	02/18/2025

GREENMAN PEDERSEN, INC 2 EXECUTIVE BUILDING SUITE 202 SUNBURG, NY 10601	ATZL NASHER, & ZIGLER 254 North Main Street New City, NY 10956
Mechanical, Electrical & Structural Engineer	Civil Engineer

RENOVATION OF ROCKLAND GREEN ADMINISTRATIVE HEADQUARTERS AND CONSTRUCTION OF AN IMMERSIVE THEATRE EXPERIENCE

TOWN OF ROCKLAND, COUNTY OF ROCKLAND  
 172 MAIN STREET  
 NAUSET, NY 10964

**MICHAEL SHILALE ARCHITECTS, LLP**  
 140 Park Avenue New City, NY 10956 Tel 845-708-9200  
 www.shilale.com

© COPYRIGHT, MICHAEL SHILALE ARCHITECTS, ALL RIGHTS RESERVED.

Drawing Title  
**PIPING RISER DIAGRAMS**

M302

**ELECTRICAL GENERAL NOTES:**

- ALL WORK SHALL BE PERFORMED IN STRICT ACCORDANCE WITH THE REQUIREMENTS OF THE 2020 NATIONAL ELECTRICAL CODE (NEC), STATE OF NEW YORK UNIFORM CONSTRUCTION CODES, THE 2020 INTERNATIONAL BUILDING CODE, 2018 IECC, AND ALL GOVERNING LOCAL CODES, LAWS, AND REGULATIONS.
- PROVIDE A COMPLETE OPERABLE SYSTEM IN A NEAT AND SKILLFUL MANNER. OUTLINE DESCRIPTION AND EQUIPMENT; DO NOT LIMIT CONTRACTOR'S LIABILITY FOR THE INSTALLATION OF A COMPLETE OPERABLE SYSTEM.
- VISIT THE SITE AND BECOME FAMILIAR WITH ALL EXISTING CONDITIONS THAT MAY AFFECT THE WORK. NO ADDITIONAL COMPENSATION WILL BE DUE FOR FAILURE TO DO SO.
- CONTRACTOR TO BE RESPONSIBLE FOR REVIEWING THE FULL SET OF BID DOCUMENTS TO BE AWARE OF THE TOTAL SCOPE PRIOR TO SUBMITTING BID. ALL WORK SHOWN ON THE DRAWINGS NOT SPECIFICALLY CALLED OUT AS EXISTING SHALL BE CONSIDERED WORK TO BE PERFORMED UNDER THIS CONTRACT.
- BIDDERS, BEFORE SUBMITTING A PROPOSAL, SHALL VISIT AND CAREFULLY EXAMINE THE SITE TO BECOME FAMILIAR WITH THE EXISTING CONDITIONS AND WITH THE DIFFICULTIES THAT WILL ATTEND THE EXECUTION OF THIS WORK. SUBMISSION OF A PROPOSAL WILL BE CONSIDERED AS EVIDENCE THAT SUCH EXAMINATION HAS BEEN MADE. LATER CLAIMS WILL NOT BE RECOGNIZED FOR EXTRA LABOR, EQUIPMENT OR MATERIALS REQUIRED BECAUSE OF DIFFICULTIES ENCOUNTERED WITHOUT FIRST SECURING SUFFICIENT PROOF IN SUPPORT OF EVIDENCE OF SUCH EXTRA CLAIMS. IT IS THE CONTRACTORS RESPONSIBILITY TO IDENTIFY AREAS WHERE INSUFFICIENT INFORMATION IS AVAILABLE, OR WHERE IT CAN BE DOCUMENTED WITH PHOTOS, AND OTHER SUPPORTING INFORMATION THAT SUCH EVIDENCE WAS BEYOND THE MEANS OF THE CONTRACTOR AS JUDGED BY THE OWNER. FINAL JUDGEMENT FOR SUCH CLAIMS SHALL BE BY THE OWNER. NO ALLOWANCE WILL SUBSEQUENTLY BE MADE TO THE CONTRACTOR BY REASON OF ANY ERROR DUE TO THE CONTRACTOR'S NEGLIGENCE TO COMPLY WITH THIS REQUIREMENT. REPORT ANY DISCREPANCIES BETWEEN DRAWINGS AND FIELD CONDITIONS TO THE ENGINEER, ARCHITECT AND OWNER.
- BEFORE COMMENCING WORK THE CONTRACTOR SHALL FILE ALL REQUIRED CERTIFICATES OF INSURANCE WITH THE BUILDING DEPARTMENT. OBTAIN ALL REQUIRED PERMITS AND PAY ALL FEES REQUIRED.
- UPON COMPLETION OF ALL ELECTRICAL WORK, ELECTRICAL CONTRACTOR SHALL ADJUST AND TEST ALL CIRCUITS, DEVICES AND ANY OTHER ELECTRICAL ITEMS INSTALLED. ANY DEFECTIVE ITEMS SHALL BE IMMEDIATELY REPAIRED OR REPLACED WITH NEW EQUIPMENT OR MATERIALS AND THAT PORTION OF THE SYSTEM SHALL BE RETESTED. ALL SUCH REMEDIAL WORK SHALL BE PROVIDED AT NO ADDITIONAL COST TO THE OWNER.
- ALL NOTATIONS OF "SCALE" ARE INTENDED AS APPROXIMATIONS. THE CONTRACTOR SHALL BE RESPONSIBLE TO ASCERTAIN THE EXACT DIMENSIONS IN FIELD.
- ELECTRICAL DRAWINGS ARE DIAGRAMMATIC. SIZES AND LOCATION OF EQUIPMENT AND WIRING ARE SHOWN TO SCALE WHERE POSSIBLE, BUT MAY BE DISTORTED FOR CLARITY ON THE DRAWINGS. LOCATIONS SHOWN ARE TO INDICATE INTENT AND SHALL BE FIELD VERIFIED.
- UNLESS OTHERWISE NOTED, ELECTRICAL EQUIPMENT INCLUDING BUT NOT LIMITED TO PULL BOXES, JUNCTION BOXES, LOW VOLTAGE SYSTEMS DEVICES, ETC. WHERE INDICATED ON DRAWINGS, SHALL BE CONSIDERED SHOWN AT THEIR APPROXIMATE LOCATION. THE CONTRACTOR SHALL LOCATE THESE ITEMS AS FIELD CONDITIONS DICTATE AND AS APPROVED BY THE ARCHITECT OR OWNER.
- ALL CONDUIT RUNS, WHEN SHOWN ON THE DRAWINGS, ARE SHOWN DIAGRAMMATICALLY TO OUTLINE THE GENERAL ROUTING OF MAJOR FEEDERS AND BRANCH WIRING. IT IS NOT WITHIN THE SCOPE OF THESE DRAWINGS TO SHOW ALL NECESSARY BENDS, OFFSETS, PULL BOXES AND OBSTRUCTIONS. IT SHALL BE THE RESPONSIBILITY OF THE CONTRACTOR TO INSTALL HIS WORK TO CONFORM TO THE REQUIREMENTS OF THE NATIONAL ELECTRICAL CODE.
- ADDITIONAL PULL AND JUNCTION BOXES NOT SHOWN ON DRAWINGS SHALL BE PROVIDED WHERE REQUIRED BY APPLICABLE CODE REQUIREMENTS OR WHERE CALLED FOR BY FIELD CONDITIONS. PULL AND JUNCTION BOXES SHALL BE SURFACE MOUNTED THROUGHOUT.
- CONDUIT RUNS SHALL CLEAR ALL ARCHITECTURAL FEATURES (DOORS, WINDOWS, ETC) AND STRUCTURAL MEMBERS. CONDUIT INSTALLATION SHALL ALSO BE MADE TO AVOID OBSTRUCTION AND CLEAR ACCESS WITH PIPES, DUCTS, OR OTHER EQUIPMENT CORRESPONDING TO OTHER TRADES, INCLUDING BUT NOT LIMITED TO MECHANICAL, ELECTRICAL, PLUMBING AND FIRE PROTECTION. SHALL ANY OF THESE ELEMENTS PREVENT THE INSTALLATION OF RACEWAY AS DELINEATED ON THE CONTRACT DOCUMENTS, DEVIATION MUST BE APPROVED BY THE ENGINEER PRIOR TO INSTALLATION. ANY VARIATION DUE TO FIELD CONDITIONS SHALL NOT REPRESENT AN ADDITIONAL COST TO OWNER.
- ALL CONDUITS BEING INSTALLED AS PART OF THIS PROJECT ARE EXPOSED EXCEPT IN AREAS WITH ACCESSIBLE HUNG CEILING. WHEN EXPOSED, CONDUIT AND BOXES SHALL BE PAINTED. PAINTING SHALL CONSIST OF A PRIME COAT AND A FINISH COAT, COLOR AS SELECTED BY ARCHITECT OR TO MATCH SURROUNDING SURFACES. FACTORY PAINTING WILL BE ACCEPTED AS A PRIME COAT. CONDUIT SHALL BE RUN ABOVE HUNG CEILING WHERE AVAILABLE.
- MINIMUM SIZE OF CONDUITS SHALL BE 3/4", UNLESS OTHERWISE NOTED. PROVIDE 2#12, 1#12G IN 3/4" CONDUIT TO 20A CIRCUIT BREAKERS IN PANELS INDICATED, UNLESS OTHERWISE NOTED.
- PROVIDE OUTLET BOXES AND ENCLOSURES APPROPRIATE FOR THE PURPOSE AT ALL LOCATIONS WHERE THE DRAWINGS REQUIRE THE INSTALLATION OF ELECTRICAL DEVICES OR ELECTRICAL EQUIPMENT.
- ALL OPENINGS BETWEEN FLOORS, THROUGH RATED FIRE AND SMOKE WALLS, CREATED BY THE CONTRACTOR FOR CONDUIT SHALL BE SEALED WITH A FIRE STOPPING MATERIAL. FIRE STOPPING MATERIAL AND ITS APPLICATION SHALL BE ACCOMPLISHED IN SUCH A MANNER THAT IS ACCEPTABLE TO THE LOCAL FIRE AND BUILDING AUTHORITIES HAVING JURISDICTION OVER THIS WORK. ANY OPENINGS CREATED BY OR FOR THE CONTRACTOR AND LEFT UNUSED SHALL ALSO BE SEALED AS PART OF THIS WORK.
- ALL EXPOSED NONCURRENT-CARRYING METAL PARTS OF ELECTRICAL EQUIPMENT AND RACEWAYS SHALL BE GROUNDED. A SEPARATE GROUND CONDUCTOR SHALL BE RUN IN ALL CONDUITS IN ALL CASES. ENSURE CONTINUITY OF THE GROUNDING CIRCUIT FROM THE SUPPLYING PANELBOARD GROUNDING BUS TO THE LOAD GROUND TERMINAL. THE RESISTANCE FROM THE SERVICE EQUIPMENT GROUND BUS TO ANY LOAD GROUND TERMINAL SHALL NOT EXCEED 1 OHM.
- NO LOW VOLTAGE WIRING SHALL BE PERMITTED IN THE SAME RACEWAY AS POWER WIRING.
- ALL ELECTRICAL EQUIPMENT AND ACCESSORIES INSTALLED OUTSIDE OR EXPOSED TO WEATHER SHALL HAVE NEMA 3R ENCLOSURES AND SHALL BE TIGHTLY GASKETED FOR A COMPLETE RAIN-TIGHT INSTALLATION.
- ALL EQUIPMENT SHALL HAVE COPPER CURRENT CARRYING PARTS INCLUDING GROUND BUS AND TERMINALS.
- REMOVE ALL DEBRIS RESULTING FROM REMOVAL AND/OR INSTALLATION OF ELECTRICAL WORK FROM THE PREMISES.
- UNLESS OTHERWISE NOTED, "INSTALL" MEANS TO BE PROVIDED AND INSTALLED BY THIS CONTRACTOR.
- CONTRACTOR TO BE RESPONSIBLE FOR ALL RESTORATION, SEALING, WATERPROOFING, PENETRATIONS, CORE DRILLING, CUTTING, PATCHING, AND PAINTING FOR THE COMPLETE CONTRACT WORK INDICATED. ALL RESTORATION WORK PERFORMED BY CONTRACTOR SHALL RESTORE DISTURBED SURFACES TO MATCH ALL SURROUNDING CONSTRUCTION.
- IF DURING THE COURSE OF THE PROJECT, ASBESTOS OR OTHER HAZARDOUS MATERIAL CONTAMINATION IS ENCOUNTERED OR SUSPECTED, THE CONTRACTOR SHALL NOTIFY THE OWNER, THE PROJECT MANAGER, AND THE DESIGN PROFESSIONAL IMMEDIATELY (WITHIN 24 HRS.) IN WRITING. CONTRACTOR WILL SUSPEND WORK IN THE AFFECTED AREA UNTIL SUCH TIME THAT THE SAID AREA IS CERTIFIED AS CONTAMINATION FREE.

**ELECTRICAL DEMOLITION NOTES:**

- THE DEMOLITION WORK SHALL BE CARRIED ON IN EVERY RESPECT IN A THOROUGH AND NEAT AND SKILLFUL MANNER.
- ALL DEMOLITION, REMOVAL, AND DISPOSAL WORK SHALL BE IN COMPLIANCE WITH THE REQUIREMENTS OF THE BUILDING CODE AND WITH ALL STATE AND FEDERAL REGULATIONS.
- REMOVE ALL DEBRIS NOT EXPLICITLY DESIGNATED TO BE SALVAGED (TO REMAIN) FROM THE PREMISES AND LEGALLY DISPOSE OF AWAY FROM PREMISES.
- ITEMS INDICATED TO BE SALVAGED SHALL BE REMOVED EITHER BEFORE DEMOLITION OR DURING THE PROCESS OF THE WORK, STORED AND PROTECTED ON THE SITE IN A LOCATION DESIGNATED BY THE OWNER'S REPRESENTATIVE. THESE ITEMS WILL BE IDENTIFIED AND RETAINED BY THE OWNER.
- CAREFULLY REMOVE AND PROTECT ALL ITEMS TO BE SAVED AND REUSED AS INDICATED ON DRAWINGS. REPLACE ANY ITEMS THAT ARE DAMAGED BY REMOVAL AT YOUR OWN COST. NOTIFY THE OWNER IN WRITING OF ANY ITEM THAT IS DAMAGED PRIOR TO REMOVAL SO THAT THEY MAY ASCERTAIN THE ITEM'S CONDITION.
- PROTECT MATERIALS, SURFACES AND STRUCTURE, WHICH ARE TO REMAIN, FROM DAMAGE; IF DAMAGE OCCURS, REPAIR OR REPLACEMENT SHALL BE MADE BY THE CONTRACTOR, TO THE SATISFACTION OF THE OWNER, AND AT THE EXPENSE OF THE CONTRACTOR.
- DISCONNECT, REMOVE AND RELOCATE ANY ELECTRICAL EQUIPMENT NOT SHOWN ON THESE DRAWINGS AS PART OF THIS CONTRACT, BUT INTERFERES WITH THE WORK UNDER THIS CONTRACT. THIS WORK SHALL NOT BE CONSIDERED EXTRA AND SHALL BE DONE AT NO ADDITIONAL COST TO THE OWNER.
- VISIT AND EXAMINE CAREFULLY THE AREAS AFFECTED BY THIS WORK TO BECOME FAMILIAR WITH EXISTING CONDITIONS AND WITH THE DIFFICULTIES THAT ATTEND THE EXECUTION OF THIS WORK. LATER CLAIMS WILL NOT BE RECOGNIZED FOR EXTRA LABOR, EQUIPMENT, OR MATERIALS REQUIRED BECAUSE OF DIFFICULTIES ENCOUNTERED.
- RELOCATE AND/OR ALTER THE EXISTING BUILDING COMPONENTS AS DIRECTED BY OWNER'S REPRESENTATIVE. ALL RELOCATION OR ALTERATIONS TO BUILDING SHALL BE RESTORED TO THEIR ORIGINAL WORKING CONDITIONS AFTER SUCH RELOCATION OR ALTERATION WORK.
- AT THE COMPLETION OF DEMOLITION WORK, ALL RUBBISH, DEBRIS AND WASTE MATERIALS SHALL BE REMOVED BY THE CONTRACTOR AND THE PREMISES SHALL BE LEFT IN CLEAN CONDITION.
- THE CONTRACTOR SHALL DISCONNECT THE CIRCUIT WIRING NOT IN USE AND SHALL REMOVE ALL NECESSARY WIRING MATERIALS, INCLUDING EXPOSED CONDUITS AND JUNCTION BOXES WHICH IMPEDE THE NEW WORK.
- MAINTAIN CONTINUITY FOR ALL EQUIPMENT TO REMAIN. PROVIDE ALL REQUIRED ACCESSORIES, WIRING AND CONDUIT AS REQUIRED.
- SUBSTANTIAL JOB COMPLETION INCORPORATES DEMOLITION OF EXISTING SYSTEMS IN CONTRACT.
- THE BUILDING FA SYSTEM SHALL BE REMOVED AND REPLACED WITH NEW. THE EXISTING FIRE ALARM SYSTEM SHALL REMAIN OPERATIONAL AT ALL TIMES DURING CONSTRUCTION UNTIL NEW SYSTEM IS INSTALLED AND APPROVED.
- CONTRACTOR TO PROVIDE ALL PHYSICAL PROTECTION REQUIRED TO PROTECT ALL EQUIPMENT DURING CONSTRUCTION.
- ALL HOLES MADE BY THE CONTRACTOR DURING CONSTRUCTION SHALL BE PROPERLY PATCHED AND REPAIRED. ALL CONDUIT PENETRATIONS THROUGH FLOORS AND WALLS SHALL BE SEALED.
- THE CONTRACTOR SHALL PERFORM ALL CUTTING, PATCHING AND REPAIRING AS REQUIRED TO COMPLETE ALL WORK INDICATED ON THE DRAWINGS, AND ALL OTHER WORK THAT MAY BE REQUIRED TO COMPLETE THE JOB.

**DRAWING LIST**

Sheet Number	Sheet Title
E001	ELECTRICAL GENERAL NOTES & SYMBOLS
ED101	ELECTRICAL FIRST FLOOR - DEMOLITION
ED102	ELECTRICAL SECOND FLOOR - DEMOLITION
ED103	ELECTRICAL ROOF - DEMOLITION
E101	ELECTRICAL FIRST FLOOR - INSTALLATION
E111	ELECTRICAL FIRST FLOOR EQUIPMENT - INSTALLATION
E102	ELECTRICAL SECOND FLOOR - INSTALLATION
E112	ELECTRICAL SECOND FLOOR EQUIPMENT - INSTALLATION
E103	ELECTRICAL ROOF PLAN - INSTALLATION
E104	ELECTRICAL SITE PLAN
E201	ELECTRICAL FIRST FLOOR RCP -INSTALLATION
E202	ELECTRICAL SECOND FLOOR RCP -INSTALLATION
E203	ELECTRICAL LIGHTING CONTROLS
E204	ELECTRICAL AV CONTROLS
E301	ELECTRICAL POWER RISER
E302	ELECTRICAL SYSTEMS PARTIAL RISERS
E401	ELECTRICAL PANEL SCHEDULES SHEET NO.1
E402	ELECTRICAL PANEL SCHEDULES SHEET NO.2
E501	ELECTRICAL DETAILS

**ABBREVIATIONS**

A	AMPERE
AC	ALTERNATING CURRENT
AF	ABOVE FINISHED FLOOR
AWG	AMERICAN WIRE GAUGE
A/C	AIR CONDITIONING
C	CONDUIT
CB	CIRCUIT BREAKER
CKT(S)	CIRCUIT(S)
CLG	CEILING
COL	COLUMN
CON	CONTINUATION
DACT	DIGITAL ALARM COMMUNICATOR TRANSMITTER
DISC	DISCONNECT
DN	DOWN
DWG	DRAWING
EC	EMPTY CONDUIT
ELEC	ELECTRIC
EM	EMERGENCY
ER	EXISTING TO BE RELOCATED
EQ	EQUAL
EXH	EXHAUST
EXIST, EX.E	EXISTING
FA	FIRE ALARM
FACP	FIRE ALARM CONTROL PANEL
FL	FLOOR
G.GND	GROUND
GFI	GROUND FAULT INTERRUPTER
HP	HORSE POWER
IG	ISOLATED GROUND
J	JUNCTION BOX
KCMIL	THOUSAND CIRCULAR MILS
KVA	KILOVOLT AMPERE
KW	KILOWATT
LTG	LIGHTING
MCB	MAIN CIRCUIT BREAKER
MLO	MAIN LUG ONLY
MTD	MOUNTED
N	NEUTRAL
N.C	NORMALLY CLOSED
NIC	NOT IN CONTRACT
N.O	NORMALLY OPEN
NTS	NOT TO SCALE
PB	PULL BOX
PNL	PANEL
Φ, F	PHASE
PWR	POWER
RE	EXISTING TO BE REMOVED
REC	RECEPTACLE
SP	SPARE
SW	SWITCH
SWBD	SWITCHBOARD
TYP	TYPICAL
U.O.N	UNLESS OTHERWISE NOTED
V	VOLT, VOLTAGE
VF	VERIFY IN FIELD
W	WATT
WAP	WIRELESS ACCESS POINT
WP	WEATHER PROOF
XFMR	TRANSFORMER
1P, 2P, 3P	SINGLE POLE, TWO POLE, THREE POLE

**POWER SYMBOLS**

	SINGLE POLE SWITCH 2 = DOUBLE POLE 3 = THREE-WAY V = VARIABLE SWITCH a = CONTROLS SWITCH LEG 'a' MO = MOMENTARY CONTACT M.2P = DISCONNECT SWITCH - TOGGLE TYPE MOTOR RATED, 20A, 2P, UON.
	NEMA 5-20R, 20A, 125V DUPLEX RECEPTACLE - FLUSH WALL MOUNTED CONTROLLED FROM WALL SWITCH 'a'
	NEMA 5-20R, 20A, 125V QUAD RECEPTACLE COMBINATION HDMI, USB, CAT6, VGA - FLUSH WALL MOUNTED OUTLET
	NEMA 5-20R, 20A, 125V DUPLEX ISOLATED GROUND COMPUTER RECEPTACLE - FLUSH WALL MOUNTED; PROVIDE WITH ORANGE TRIANGLE ON FACEPLATE OF RECEPTACLE PER CODE.
	NEMA 5-20R, 20A, 125V DEDICATED DUPLEX RECEPTACLE - FLUSH WALL MOUNTED. GFI DENOTES GROUND FAULT INTERRUPTER.
	NEMA 5-20R, 20A, 125V QUAD RECEPTACLE - FLUSH WALL MOUNTED
	NEMA 5-20R, 20A, 125V DEDICATED QUADRUPLUX RECEPTACLE - FLUSH WALL MOUNTED
	SINGLE SPECIAL PURPOSE RECEPTACLE - FLUSH WALL MOUNTED LETTER = TYPE A' - (15A) NEMA CONFIG. 6-15R, 250V, 2P, 3W, GROUNDED B' - (20A) NEMA CONFIG. 6-20R C' - (30A) NEMA CONFIG. 6-30R D' - (50A) NEMA CONFIG. 6-50R
	COORDINATE MOUNTING HEIGHTS OF DEVICES WITH ARCHITECT AND FURNITURE INSTALLATIONS.
	HOMERUN-NUMERAL WHERE USED INDICATES CIRCUIT NUMBER FOR REFERENCE ONLY. 2#12+1#12G-3/4"C FOR ONE CKT. HOMERUN, U.O.N. 3#12+1#12G-3/4"C FOR TWO CKT. HOMERUN, U.O.N. 4#12+1#12G-3/4"C FOR THREE CKT. HOMERUN, U.O.N.
	JUNCTION BOX
	FUSED DISCONNECT SWITCH, VOLTAGE RATING AS REQUIRED '100' - DENOTES SWITCH SIZE '60' - DENOTES FUSE SIZE IF INDICATED '3P' - DENOTES NUMBER OF POLES
	NON-FUSED DISCONNECT SWITCH, VOLTAGE RATING AS REQUIRED BRANCH CIRCUIT PROTECTIVE DEVICE '30A' - DENOTES SWITCH SIZE '3P' - DENOTES NUMBER OF POLES
	VARIABLE FREQUENCY DRIVE/MOTOR STARTER, VOLTAGE RATING AS REQUIRED BRANCH CIRCUIT PROTECTIVE DEVICE '30A' - DENOTES AMPERAGE RATING
	METER
	SURFACE MOUNTED LIGHTING/POWER PANELBOARD
	RECESSED MOUNTED LIGHTING/POWER PANELBOARD
	EXISTING CONDUIT STUB UPS TO FURNITURE TO REMAIN.
	FLUSH FLOOR MOUNTED FIRE RATED COMBINATION FLOOR BOX. PROVIDE COMBINATION TYPE OF RECEPTACLES AND/OR TELECOMMUNICATIONS OUTLETS AS INDICATED BY SYMBOLS. COORDINATE COMPONENT REQUIREMENTS WITH CLIENT. VIF CONDUIT ROUTING/LOCATION OF DEVICE. COORDINATE WITH MANUFACTURER TO PROVIDE ALL COMPONENTS REQUIRED FOR A COMPLETE SYSTEM INSTALLATION. PROVIDE LEGRAND, MODEL EF88S, OR APPROVED EQUIVALENT. RUN 3/4"C FOR POWER AND 1-1/4"C FOR COMMUNICATIONS. TERMINATE ENDS WITH BUSHING.
	FLUSH WALL MOUNTED JUNCTION BOX FOR POWER WIRING TO FURNITURE RACEWAY SYSTEM. PROVIDE FLEXIBLE CONDUIT CONNECTION FROM THE JUNCTION BOX TO RACEWAY SYSTEM; 3/4" C FOR POWER FEED
	FLUSH WALL MOUNTED JUNCTION BOX FOR COMMUNICATION WIRING TO FURNITURE RACEWAY SYSTEM. PROVIDE FLEXIBLE CONDUIT CONNECTION FROM THE JUNCTION BOX TO RACEWAY SYSTEM AND 1-1/4" EMPTY CONDUIT WITH (2) PULL STRINGS STUBBED 6" ABOVE ACCESSIBLE HUNG CEILING AND TERMINATED WITH BUSHING. PROVIDE WITH (2) DATA DROPS PER WORKSTATION.
	WALL MOUNTED GROUND BUS BAR
	EXISTING CONDUIT/EQUIPMENT TO REMAIN
	CONDUIT TRENCHED IN SLAB
	CONDUIT STUBBED UP
	CONDUIT OPENING OUT TO FLOOR
	CONDUIT END WITH BUSHING

**COMMUNICATION SYMBOLS**

	WALL MOUNTED OUTLET IN DOUBLE GANG BOX WITH SINGLE GANG REDUCER PLATE AND 1" EMPTY CONDUIT WITH (2) PULL STRINGS STUBBED 6" ABOVE ACCESSIBLE HUNG CEILING IN A 90 DEGREE BEND AND TERMINATED WITH BUSHING. PROVIDE WITH 2 DATA JACKS.
	WALL MOUNTED DATA OUTLET IN DOUBLE GANG BOX WITH SINGLE GANG REDUCER PLATE AND 1" EMPTY CONDUIT WITH (2) PULL STRINGS STUBBED 6" ABOVE ACCESSIBLE HUNG CEILING IN A 90 DEGREE BEND AND TERMINATED WITH BUSHING.
	WALL MOUNTED DATA OUTLET IN DOUBLE GANG BOX AND 1-1/4" EMPTY CONDUIT WITH (2) PULL STRINGS STUBBED 6" ABOVE ACCESSIBLE HUNG CEILING IN A 90 DEGREE BEND AND TERMINATED WITH BUSHING.
	WALL MOUNTED AUDIO/VISUAL OUTLET IN DOUBLE GANG BOX AND 1-1/4" EMPTY CONDUIT WITH (2) PULL STRINGS STUBBED 6" ABOVE ACCESSIBLE HUNG CEILING IN A 90 DEGREE BEND AND TERMINATED WITH BUSHING.
	WALL MOUNTED THERMOSTAT. PROVIDE DOUBLE GANG BOX, 1" EMPTY CONDUIT WITH PULL STRING STUBBED 6" ABOVE ACCESSIBLE HUNG CEILING IN A 90 DEGREE BEND AND TERMINATED WITH BUSHING. COORDINATE INSTALLATIONS WITH MECHANICAL CONTRACTOR.
	WIRELESS ACCESS POINT
	CEILING MOUNTED PA SPEAKER
	CEILING MOUNTED OUTLET IN DOUBLE GANG BOX WITH SINGLE GANG REDUCER PLATE. HORIZONTAL CAT6 CABLES TO BE SUPPORTED VIA J-HOOKS. VERTICAL RUNS SHALL BE IN 1" CONDUIT WITH (2) PULL STRINGS STUBBED 6" ABOVE ACCESSIBLE HUNG CEILING IN A 90 DEGREE BEND AND TERMINATED WITH BUSHING. PROVIDE WITH OUTLET WITH 2 DATA JACKS.
	CEILING MOUNTED OUTLET IN DOUBLE GANG BOX WITH SINGLE GANG REDUCER PLATE. HORIZONTAL CAT6 CABLES TO BE SUPPORTED VIA J-HOOKS. VERTICAL RUNS SHALL BE IN 1" CONDUIT WITH (2) PULL STRINGS STUBBED 6" ABOVE ACCESSIBLE HUNG CEILING IN A 90 DEGREE BEND AND TERMINATED WITH BUSHING. PROVIDE WITH OUTLET WITH 1 DATA JACK
	CEILING MOUNTED OUTLET IN DOUBLE GANG BOX WITH SINGLE GANG REDUCER PLATE. HORIZONTAL AND VERTICAL RUN SHALL BE IN 1" CONDUIT WITH (2) PULL STRINGS STUBBED 6" ABOVE ACCESSIBLE HUNG CEILING IN A 90 DEGREE BEND AND TERMINATED WITH BUSHING. PROVIDE WITH HDMI CABLE.
	DACT DEDICATED PHONE CONNECTION TO FIRE ALARM. REFER TO FIRE ALARM DRAWINGS.
	SYSTEMS RISER SYMBOL: REFER TO FLUSH FLOOR MOUNTED COMBINATION POKE-THRU SYMBOL DESCRIPTION. SUPERSCRIP "FF" DENOTES FLOOR MOUNTED FURNITURE WHIPS SUPERSCRIP "PT" DENOTES FLOOR MOUNTED OUTLET. FOR SUBSCRIPT "HX", LETTER DENOTES QTY OF DATA RUNS.
	WALL MOUNTED SPEAKER; SUBSCRIPT "SP" DENOTES SPEAKER FOR THEATER; SUBSCRIPT "SW" DENOTES SUBWOOFER FOR THEATER
	MAIN DATA RACK
	THEATER 21 U RACK

**LIGHTING SYMBOLS**

	2'x4'2"x2'1"x4' FLUORESCENT CEILING MOUNTED FIXTURE A' = FIXTURE TYPE a' = CONTROLLED BY SWITCH 'a' NS = NOT SWITCHED NL = NIGHT LIGHT
	SIMILAR TO ABOVE WITH EMERGENCY BACKUP
	A' = FIXTURE TYPE a' = CONTROLLED BY SWITCH 'a' CEILING MOUNTED EXIT LIGHT - DIRECTIONAL ARROWS WHERE INDICATED - SHADED AREAS INDICATE ILLUMINATED FACE/FACES A' = FIXTURE TYPE
	EXIT SIGN WITH EMERGENCY LIGHT
	CEILING MOUNTED SENSOR: 'OC' DENOTES OCCUPANCY SENSOR; 'VS' DENOTES VACANCY SENSOR; 'DL' DENOTES PHOTO SENSOR. * a' DENOTES ZONE CONTROL.
	POWER PACKS; FINAL OPTION PER APPROVED MANUFACTURER. PD DENOTES FOR DAYLIGHT ZONE DIMMING) PP DENOTES (DIMMING OPTION) PI DENOTES (NON-DIMMING OPTION) EM DENOTES (EMERGENCY OPTION)
	HUB
	WALL MOUNTED TWO-ZONE RAISE/LOWER SWITCH. PROVIDE NECESSARY APPURTENANCES FOR A COMPLETE INSTALLATION.
	WALL MOUNTED SINGLE MULTI-ZONE RAISE/LOWER SWITCH FOR OPEN AREA ZONE CONTROL. PROVIDE NECESSARY APPURTENANCES FOR A COMPLETE INSTALLATION. LETTER(S) DENOTES LIGHTING ZONE DESIGNATION. REFER TO DWG. E203.
	WALL MOUNTED MAIN AREA, CORRIDOR AND OPEN AREA SWITCH. LETTER DENOTES LIGHTING ZONE DESIGNATION. REFER TO DWG. E203 FOR SWITCH TYPE AND LIGHTING CONTROL PACKAGE.
	WALL MOUNTED TWO ZONE RAISE/LOWER SWITCH(ES) TO SUIT APPLICATION.
	WALL MOUNTED LINE-VOLTAGE SINGLE-ZONE RAISE/LOWER SWITCH WITH OCCUPANCY SENSOR.
	WALL MOUNTED LINE-VOLTAGE OCCUPANCY SENSOR SWITCH. LETTER DENOTES LIGHTING ZONE DESIGNATION.
	WALL MOUNTED LINE-VOLTAGE VACANCY SENSOR SWITCH. LETTER DENOTES LIGHTING ZONE DESIGNATION.
	SECTION A # = DRAWING NUMBER

No.	Date	Revisions
3	04-10-25	ADDENDUM NO. 3
0	02-18-25	RFF SET

Drawn by	JL
Checked by	SH
Project No.	40034C
Scale	NONE
Date	02/18/2025

**GREENMAN PEDERSEN, INC**  
2 EXECUTIVE BUILDING  
SUITE 202  
SPRINGFIELD, NJ 07081

**ATZL NASHER, & ZIGLER**  
204 North Main Street  
New York, NY 10005

Mechanical & Structural Engineer

Civil Engineer

**RENOVATION OF ROCKLAND GREEN ADMINISTRATIVE HEADQUARTERS AND CONSTRUCTION OF AN IMMERSIVE THEATRE EXPERIENCE**

172 MAIN STREET  
MAUNTLIN, NY 10854

TOWN OF CLARKSTOWN  
COUNTY OF ROCKLAND


**MSA**

MICHAEL SHILAIE ARCHITECTS, LLP  
140 Park Avenue New York, NY 10095 Tel 845-708-9200  
www.shilaie.com

© COPYRIGHT, MICHAEL SHILAIE ARCHITECTS. ALL RIGHTS RESERVED.

Drawing Title  
**ELECTRICAL GENERAL NOTES & SYMBOLS**

Drawing No.  
**E001**

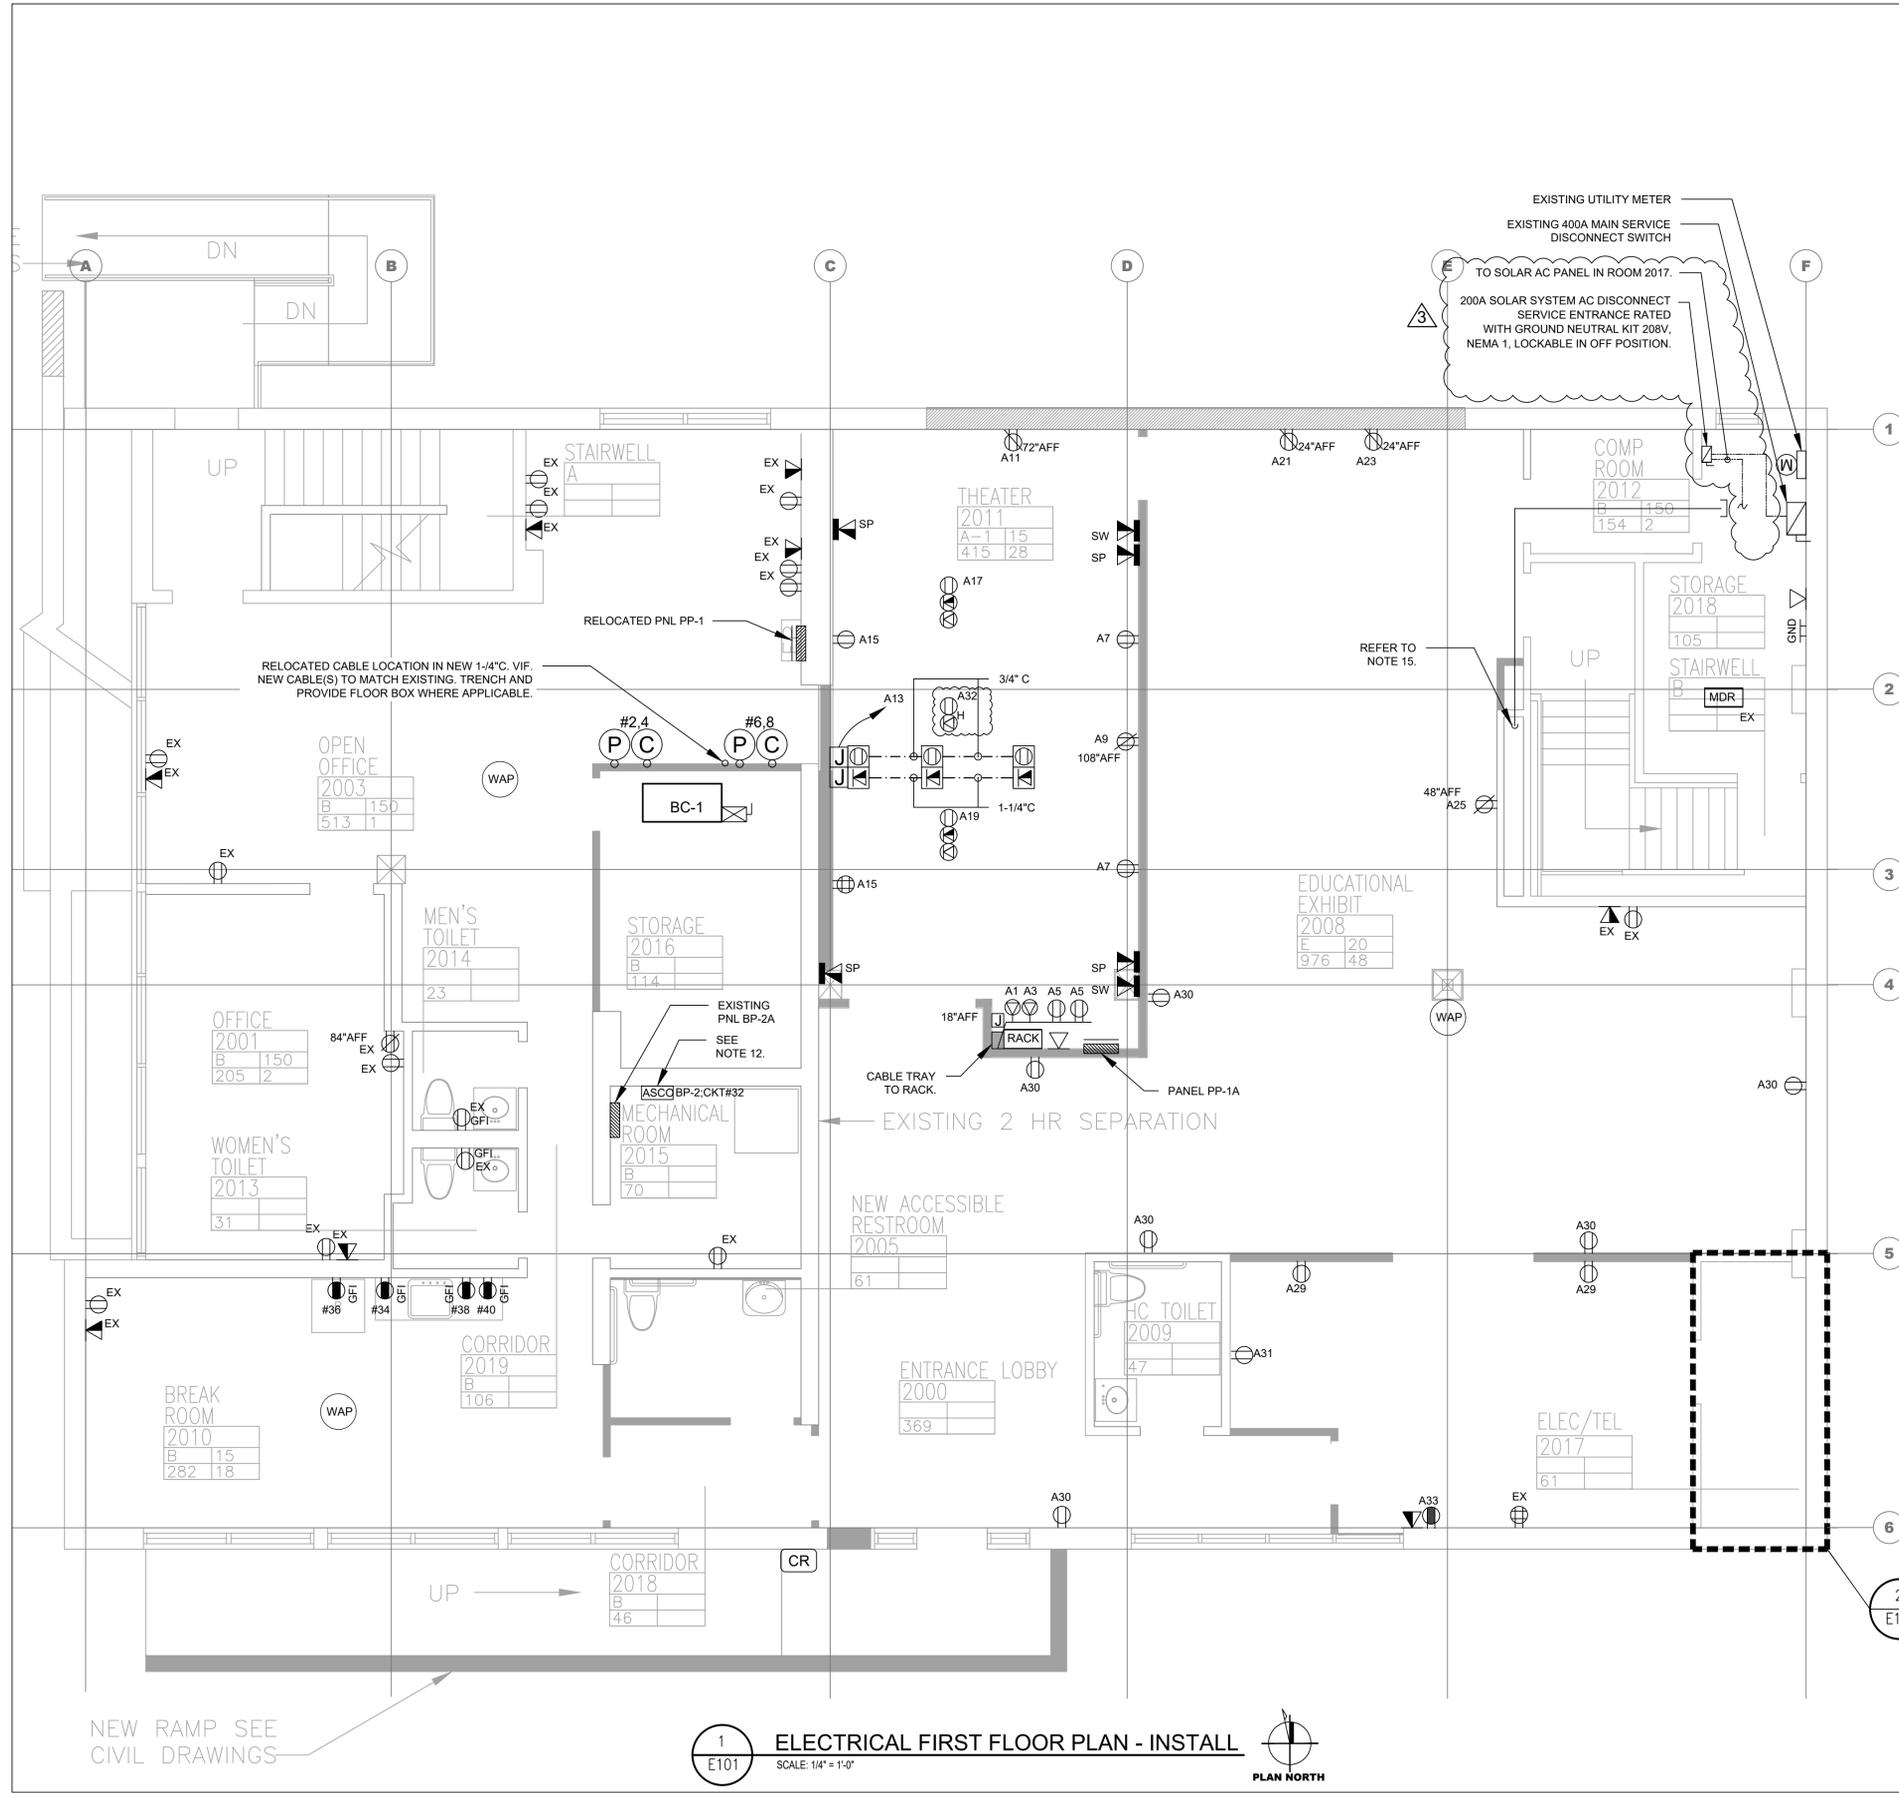


**1 ELECTRICAL FIRST FLOOR PLAN - INSTALL**  
 SCALE: 1/4" = 1'-0"  
 PLAN NORTH

**PLAN NOTES:**

- FOR GENERAL NOTES, ABBREVIATIONS AND ELECTRICAL SYMBOLS, REFER TO DWG. E001.
- COORDINATE LOCATION OF BASE BUILDING ELECTRICAL PANELS WITH PROPERTY MANAGER.
- ALL WIRING SHALL BE #12 AWG, #12 AWG GND IN 3/4" C. U.O.N.
- CIRCUIT NUMBERS ARE FOR IDENTIFICATION PURPOSES ONLY.
- UPDATE ALL EXISTING PANELBOARD DIRECTORIES AFFECTED BY NEW WORK. REFER TO PANELBOARD DESIGNATION LEGEND FOR IDENTIFICATION OF PANELBOARDS AND CIRCUITS.
- CONTRACTOR SHALL MAINTAIN CONTINUITY TO ALL EXISTING CIRCUITRY TO REMAIN WHICH ARE AFFECTED BY THE SCOPE OF WORK; CONTRACTOR SHALL FURNISH ALL NECESSARY JUNCTION BOXES, CONDUIT, AND WIRES ARE REQUIRED.
- ALL OUTLET LOCATION AND MOUNTING HEIGHTS ARE PER ARCHITECT PLANS AND FIELD CONDITIONS. COORDINATE WITH ARCHITECT.
- REFER TO MECHANICAL AND PLUMBING PLANS FOR EQUIPMENT TO BE SUPPLIED BY OTHER TRADES AND INSTALLED/WIRED UNDER THIS SECTION. COORDINATE WITH MECHANICAL CONTRACTOR FOR THERMOSTAT LOCATIONS.
- REFER TO E111, E112, E103 AND E104 FOR POWER CONNECTIONS TO MECHANICAL AND/OR PLUMBING EQUIPMENT TO BE SUPPLIED BY OTHER TRADES AND INSTALLED/WIRED UNDER THIS SECTION. COORDINATE WITH MECHANICAL CONTRACTOR FOR THERMOSTAT LOCATIONS.
- ALL TEL/DATA CABLEING TO BE BY SYSTEMS VENDOR; COORDINATE LOCATIONS/ROUTING WITH SYSTEMS VENDOR.
- PROVIDE DATA CONNECTIONS TO AUDIO VISUAL EQUIPMENT AS PER AUDIO RISER DIAGRAM. COORDINATE WORK WITH AV VENDOR.
- PROVIDE ALL OUTLETS WITHIN 6FT. OF SINK WITH GFI RECEPTACLES AS PER NEC REQUIREMENTS.
- UTILIZE PANEL PP-1 (#XX) AND PANEL PP-1A (###) TO POWER CIRCUITS INDICATED WITHIN THE AREA OF WORK, UON.
- ASCO TO SHUT DOWN WATER HEATER LOCATED IN ROOM 2015. WHERE REQUIRED. RUN #12 IN 3/4" C TO PANEL BP-2 TO POWER ASCO. VERIFY LOCATION OF DEVICE IN FIELD.
- PROVIDE 2" EG TO SECOND FLOOR CEILING FOR VERTICAL DATA CABLE RUNS FROM MDR RACK TO SERVE NEW DATA OUTLETS ON THE SECOND FLOOR. VERIFY LOCATION OF CONDUIT IN FIELD. UTILIZE J-HOOKS FOR HORIZONTAL CABLE RUNS IN SECOND FLOOR CEILING, U.O.N..
- DATA CABLES SHALL NOT BE VISIBLE IN EXHIBIT 2008 CEILING. RUN CABLES IN CONDUIT TO NEAREST ACCESSIBLE HUNG CEILING OR DOWN DIRECTLY TO OUTLET IN FULL HEIGHT PARTITIONS.
- PROVIDE CABLE TRAY FOR CABLE RUNS TO THEATER RACK. COORDINATE REQUIREMENTS WITH WHIRLWIND AND ARCHITECT.
- REFER TO WHIRLWIND AUDIO/VISUAL DRAWINGS FOR POWER AND COMMUNICATION REQUIREMENTS FOR THEATER AND EXHIBIT SPACE. PROVIDE ALL NECESSARY ANCILLARY COMPONENTS AS REQUIRED FOR A FULLY FUNCTIONAL SYSTEM INSTALLATION. PROVIDE CABLES, POWER, CONDUITS, ROUGH-INS, ETC. COORDINATE LOCATIONS AND REQUIREMENTS WITH WHIRLWIND AND THE ARCHITECT.
- CONTRACTOR TO SUBMIT ELECTRICAL ROOM EQUIPMENT LAYOUT WITH DIMENSIONS FOR REVIEW AND APPROVAL PRIOR TO PERFORMING THE WORK.

**2 ELECTRICAL ROOM PART PLAN - INSTALL**  
 SCALE: 1/4" = 1'-0"

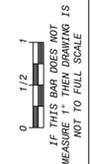

No.	Date	Revisions
3	04-10-25	ADDENDUM NO. 3
0	02-18-25	RFF SET


Drawn by	JL
Checked by	SH
Project No.	40034G
Scale	
Date	02/18/2025

<b>GREENMAN PEDERSEN, INC</b> 2 EXECUTIVE BOULEVARD SUITE 202 SARASOTA, FL 34236	<b>ATZL NASHER, &amp; ZIGLER</b> 254 North Main Street New York, NY 10003
Mechanical & Structural Engineer	Civil Engineer

**RENOVATION OF ROCKLAND GREEN ADMINISTRATIVE HEADQUARTERS AND CONSTRUCTION OF AN IMMERSIVE THEATRE EXPERIENCE**  
 172 MAIN STREET  
 NAUSETT, NY 10864  
 TOWN OF CLARINGTON  
 COUNTY OF ROCKLAND



© COPYRIGHT, MICHAEL SHILALE ARCHITECTS, ALL RIGHTS RESERVED.  
 Drawing Title: **ELECTRICAL FIRST FLOOR - INSTALLATION**  
 Drawing No.: **E101**

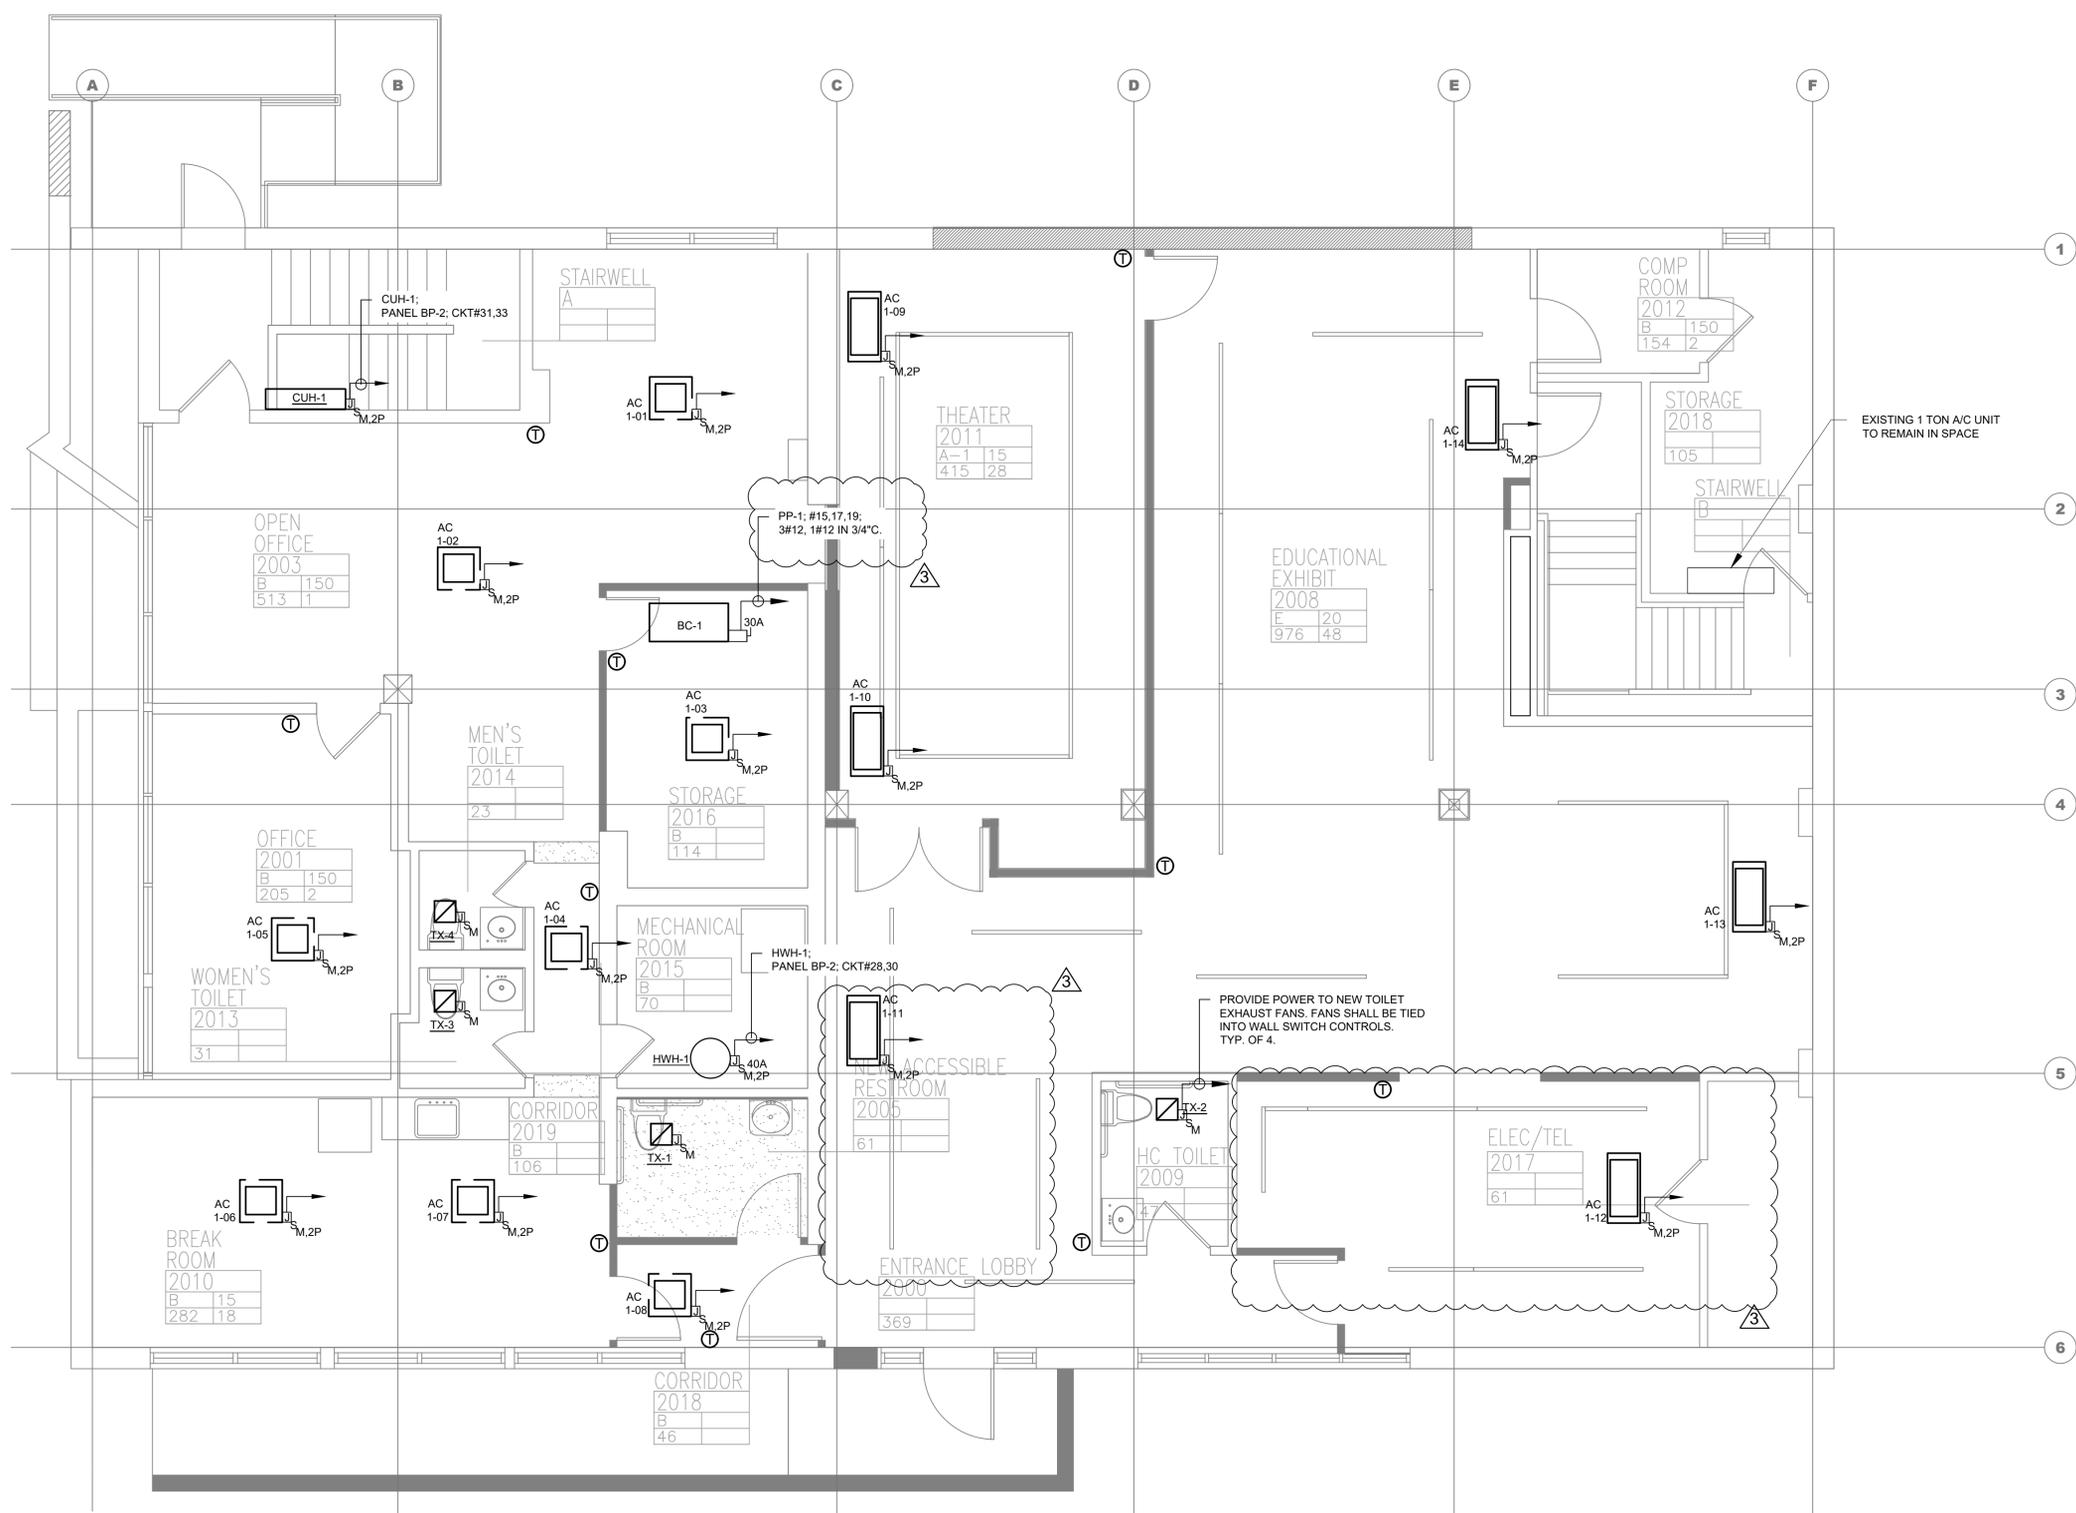

0 1/2  
 IF THIS BAR DOES NOT  
 MEASURE 1" THEN DRAWING IS  
 NOT TO FULL SCALE

**PLAN NOTES:**

- FOR GENERAL NOTES, ABBREVIATIONS AND ELECTRICAL SYMBOLS, REFER TO DWG. E001.
- COORDINATE LOCATION OF BASE BUILDING ELECTRICAL PANELS WITH PROPERTY MANAGER.
- ALL WIRING SHALL BE 2#12 AWG, 1#12 AWG GND IN 3/4" C. U.O.N.
- CIRCUIT NUMBERS ARE FOR IDENTIFICATION PURPOSES ONLY.
- UPDATE ALL EXISTING PANELBOARD DIRECTORIES AFFECTED BY NEW WORK. REFER TO PANELBOARD DESIGNATION LEGEND FOR IDENTIFICATION OF PANELBOARDS AND CIRCUITS.
- CONTRACTOR SHALL MAINTAIN CONTINUITY TO ALL EXISTING CIRCUITRY TO REMAIN WHICH ARE AFFECTED BY THE SCOPE OF WORK; CONTRACTOR SHALL FURNISH ALL NECESSARY JUNCTION BOXES, CONDUIT, AND WIRES ARE REQUIRED.
- ALL OUTLET LOCATION AND MOUNTING HEIGHTS ARE PER ARCHITECT PLANS AND FIELD CONDITIONS. COORDINATE WITH ARCHITECT.
- REFER TO MECHANICAL AND PLUMBING PLANS FOR EQUIPMENT TO BE SUPPLIED BY OTHER TRADES AND INSTALLED/WIRED UNDER THIS SECTION. COORDINATE WITH MECHANICAL CONTRACTOR FOR THERMOSTAT LOCATIONS.
- PROVIDE 120V CKT FOR CONTROL PANEL SERVING MECHANICAL EQUIPMENT.
- REFER TO MECHANICAL SCHEDULES AND ELECTRICAL PANEL SCHEDULES FOR POWER REQUIREMENTS TO EQUIPMENT ON PLAN.

No.	Date	Revisions
3	04-10-25	ADDENDUM NO. 3
0	02-18-25	RFP SET

Drawn by	JL
Checked by	AL
Project No.	40034G
Scale	
Date	02/18/2025


<b>GREENMAN PEDERSEN, INC</b> 2 EXECUTIVE BOULEVARD SUITE 202 SPRINGFIELD, NY 10901	<b>ATZL NASHER, &amp; ZIGLER</b> 254 North Main Street New City, NY 10956
Mechanical, Electrical & Structural Engineer	Civil Engineer

**RENOVATION OF ROCKLAND GREEN ADMINISTRATIVE HEADQUARTERS AND CONSTRUCTION OF AN IMMERSIVE THEATRE EXPERIENCE**  
 TOWN OF CLANSTON, COUNTY OF ROCKLAND  
 172 MAIN STREET, NAUSETT, NY 10964




© COPYRIGHT, MICHAEL SHILALE ARCHITECTS, ALL RIGHTS RESERVED.  
 Drawing Title  
**ELECTRICAL FIRST FLOOR EQUIPMENT - INSTALLATION**  
 Drawing No.  
**E111**

1  
 E111  
**ELECTRICAL FIRST FLOOR PLAN - INSTALL**  
 SCALE: 1/4" = 1'-0"

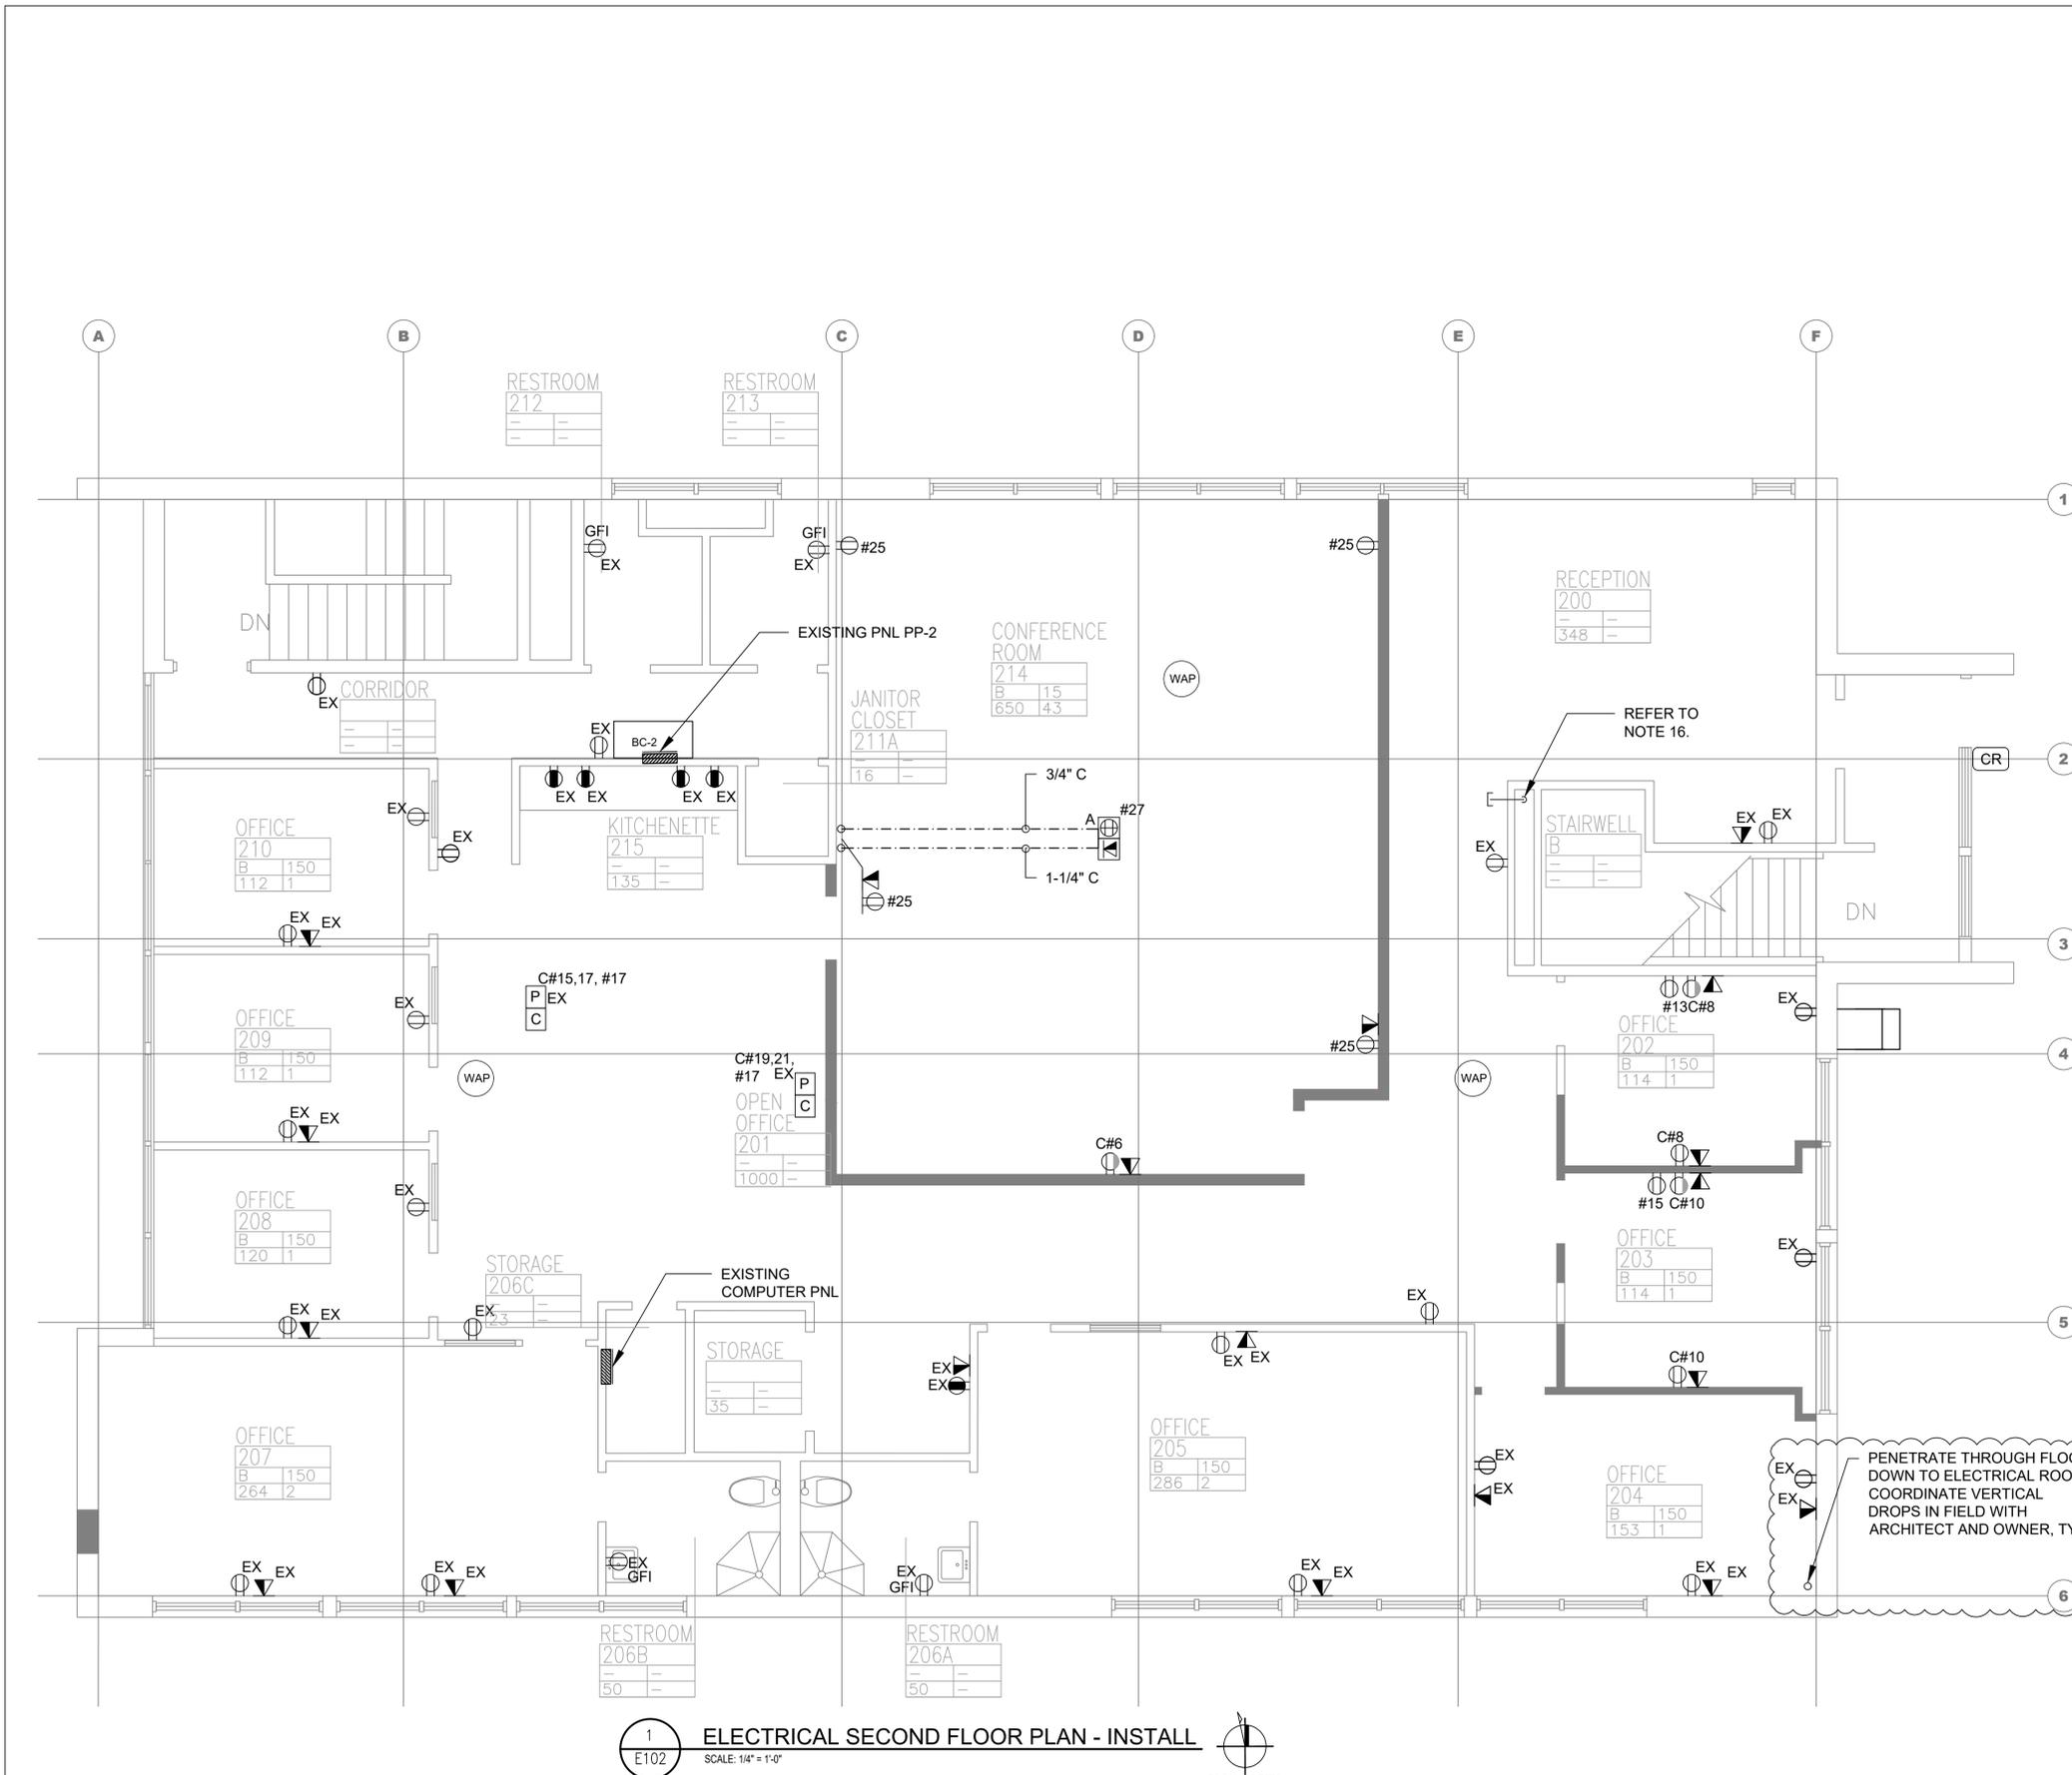

**PLAN NOTES:**

3. ALL WIRING SHALL BE 2#12 AWG, 1#12 AWG GND IN 3/4" C, U.O.N.
4. CIRCUIT NUMBERS ARE FOR IDENTIFICATION PURPOSES ONLY.
5. UPDATE ALL EXISTING PANELBOARD DIRECTORIES AFFECTED BY NEW WORK. REFER TO PANELBOARD DESIGNATION LEGEND FOR IDENTIFICATION OF PANELBOARDS AND CIRCUITS.
6. CONTRACTOR SHALL MAINTAIN CONTINUITY TO ALL EXISTING CIRCUITRY TO REMAIN WHICH ARE AFFECTED BY THE SCOPE OF WORK. CONTRACTOR SHALL FURNISH ALL NECESSARY JUNCTION BOXES, CONDUIT, AND WIRES ARE REQUIRED.
7. ALL OUTLET LOCATION AND MOUNTING HEIGHTS ARE PER ARCHITECT PLANS AND FIELD CONDITIONS, COORDINATE WITH ARCHITECT.
8. REFER TO MECHANICAL AND PLUMBING PLANS FOR EQUIPMENT TO BE SUPPLIED BY OTHER TRADES AND INSTALLED/WIRED UNDER THIS SECTION. COORDINATE WITH MECHANICAL CONTRACTOR FOR THERMOSTAT LOCATIONS.
9. REFER TO E111, E112, E103 AND E104 FOR POWER CONNECTIONS TO MECHANICAL AND/OR PLUMBING EQUIPMENT TO BE SUPPLIED BY OTHER TRADES AND INSTALLED/WIRED UNDER THIS SECTION. COORDINATE WITH MECHANICAL CONTRACTOR FOR THERMOSTAT LOCATIONS.
10. ALL TEL/DATA CABLING TO BE BY SYSTEMS VENDOR; COORDINATE LOCATIONS/ROUTING WITH SYSTEMS VENDOR.
11. PROVIDE DATA CONNECTIONS TO AUDIO VISUAL EQUIPMENT AS PER AUDIO RISER DIAGRAM. COORDINATE WORK WITH AV VENDOR.
12. PROVIDE ALL OUTLETS WITHIN 6FT. OF SINK WITH GFI RECEPTACLES AS PER NEC REQUIREMENTS.
13. UTILIZE COMPUTER PANEL (C#XX) TO POWER CIRCUITS INDICATED WITHIN THE AREA OF WORK, UON.
14. PROVIDE 120V CKT CONNECTIONS TO AWNING SIGNAGE. REFER TO ARCHITECTURAL PLANS FOR OUTLET INSTALLATION LOCATIONS. COORDINATE WITH VENDOR TO VERIFY ALL COMPONENTS REQUIRED FOR A COMPLETE INSTALLATION.
15. PROVIDE EACH WORK STATION WITH THE FOLLOWING: (1) DUPLEX REC FROM PANEL PP-2, (1) DEDICATED DUPLEX RECEPTACLE FROM "COMPUTER PANEL", (2) DATA JACKS.
16. 2" EC WITH (2) PULL STRINGS STUBBED 6" ABOVE ACCESSIBLE HUNG 2ND FLOOR CEILING IN A 90 DEGREE BEND AND TERMINATED CONDUIT ENDS WITH BUSHING.

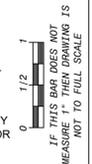

1 ELECTRICAL SECOND FLOOR PLAN - INSTALL  
 SCALE: 1/4" = 1'-0"  
 PLAN NORTH

No.	Date	Revisions
3	04-10-25	ADDENDUM NO. 3
0	02-18-25	RFF SET

Drawn by	JL
Checked by	SH
Project No.	40034G
Scale	
Date	02/18/2025

<b>GREENMAN PEDERSEN, INC</b> 2 EXECUTIVE BOULEVARD SUITE 202 SPRINGFIELD, NY 10901	<b>ATZL NASHER, &amp; ZIGLER</b> 254 North Main Street New City, NY 10956
Mechanical, Electrical, & Structural Engineer	Civil Engineer

RENOVATION OF ROCKLAND GREEN ADMINISTRATIVE HEADQUARTERS AND CONSTRUCTION OF AN IMMERSIVE THEATRE EXPERIENCE  
 172 MAIN STREET  
 NAUSETT, NY 10964  
 TOWN OF CLANSTON, COUNTY OF ROCKLAND



© COPYRIGHT, MICHAEL SHILALE ARCHITECTS, ALL RIGHTS RESERVED.  
 Drawing Title  
**ELECTRICAL SECOND FLOOR - INSTALLATION**  
 Drawing No.  
**E102**

**PLAN NOTES:**

- FOR GENERAL NOTES, ABBREVIATIONS AND ELECTRICAL SYMBOLS, REFER TO DWG. E001.
- COORDINATE LOCATION OF BASE BUILDING ELECTRICAL PANELS WITH PROPERTY MANAGER.
- ALL WIRING SHALL BE 2#12 AWG, 1#12 AWG GND IN 3/4" C, U.O.N.
- CIRCUIT NUMBERS ARE FOR IDENTIFICATION PURPOSES ONLY.
- UPDATE ALL EXISTING PANELBOARD DIRECTORIES AFFECTED BY NEW WORK. REFER TO PANELBOARD DESIGNATION LEGEND FOR IDENTIFICATION OF PANELBOARDS AND CIRCUITS.
- CONTRACTOR SHALL MAINTAIN CONTINUITY TO ALL EXISTING CIRCUITRY TO REMAIN WHICH ARE AFFECTED BY THE SCOPE OF WORK; CONTRACTOR SHALL FURNISH ALL NECESSARY JUNCTION BOXES, CONDUIT, AND WIRES ARE REQUIRED.
- ALL OUTLET LOCATION AND MOUNTING HEIGHTS ARE PER ARCHITECT PLANS AND FIELD CONDITIONS. COORDINATE WITH ARCHITECT.
- REFER TO MECHANICAL AND PLUMBING PLANS FOR EQUIPMENT TO BE SUPPLIED BY OTHER TRADES AND INSTALLED/WIRED UNDER THIS SECTION. COORDINATE WITH MECHANICAL CONTRACTOR FOR THERMOSTAT LOCATIONS.
- PROVIDE 120V CKT FOR CONTROL PANEL SERVING MECHANICAL EQUIPMENT.
- REFER TO MECHANICAL SCHEDULES AND ELECTRICAL PANEL SCHEDULES FOR POWER REQUIREMENTS TO EQUIPMENT ON PLAN.



No.	Date	Revisions
3	04-10-25	ADDENDUM NO. 3
0	02-18-25	RFP SET

Drawn by	JL
Checked by	AL
Project No.	40034G
Scale	
Date	02/18/2025


GREENMAN PEDERSEN, INC 2 EXECUTIVE BOULEVARD SUITE 202 SPRINGFIELD, NJ 07081	ATZL NASHER & ZIGLER 224 North Main Street New York, NY 10005
Mechanical, Electrical & Structural Engineer	Civil Engineer

RENOVATION OF ROCKLAND GREEN ADMINISTRATIVE HEADQUARTERS AND CONSTRUCTION OF AN IMMERSIVE THEATRE EXPERIENCE 172 MAIN STREET NAUSETT, NY 10864	TOWN OF ROCKLAND COUNTY OF ROCKLAND
--	--


MSA MICHAEL SHILALE ARCHITECTS, LLP 140 Park Avenue New City, NY 10956 Tel 845-708-9200 www.shilale.com
--

© COPYRIGHT, MICHAEL SHILALE ARCHITECTS. ALL RIGHTS RESERVED. Drawing Title <b>ELECTRICAL SECOND FLOOR EQUIPMENT - INSTALLATION</b>
---

Drawing No. <b>E112</b>
----------------------------

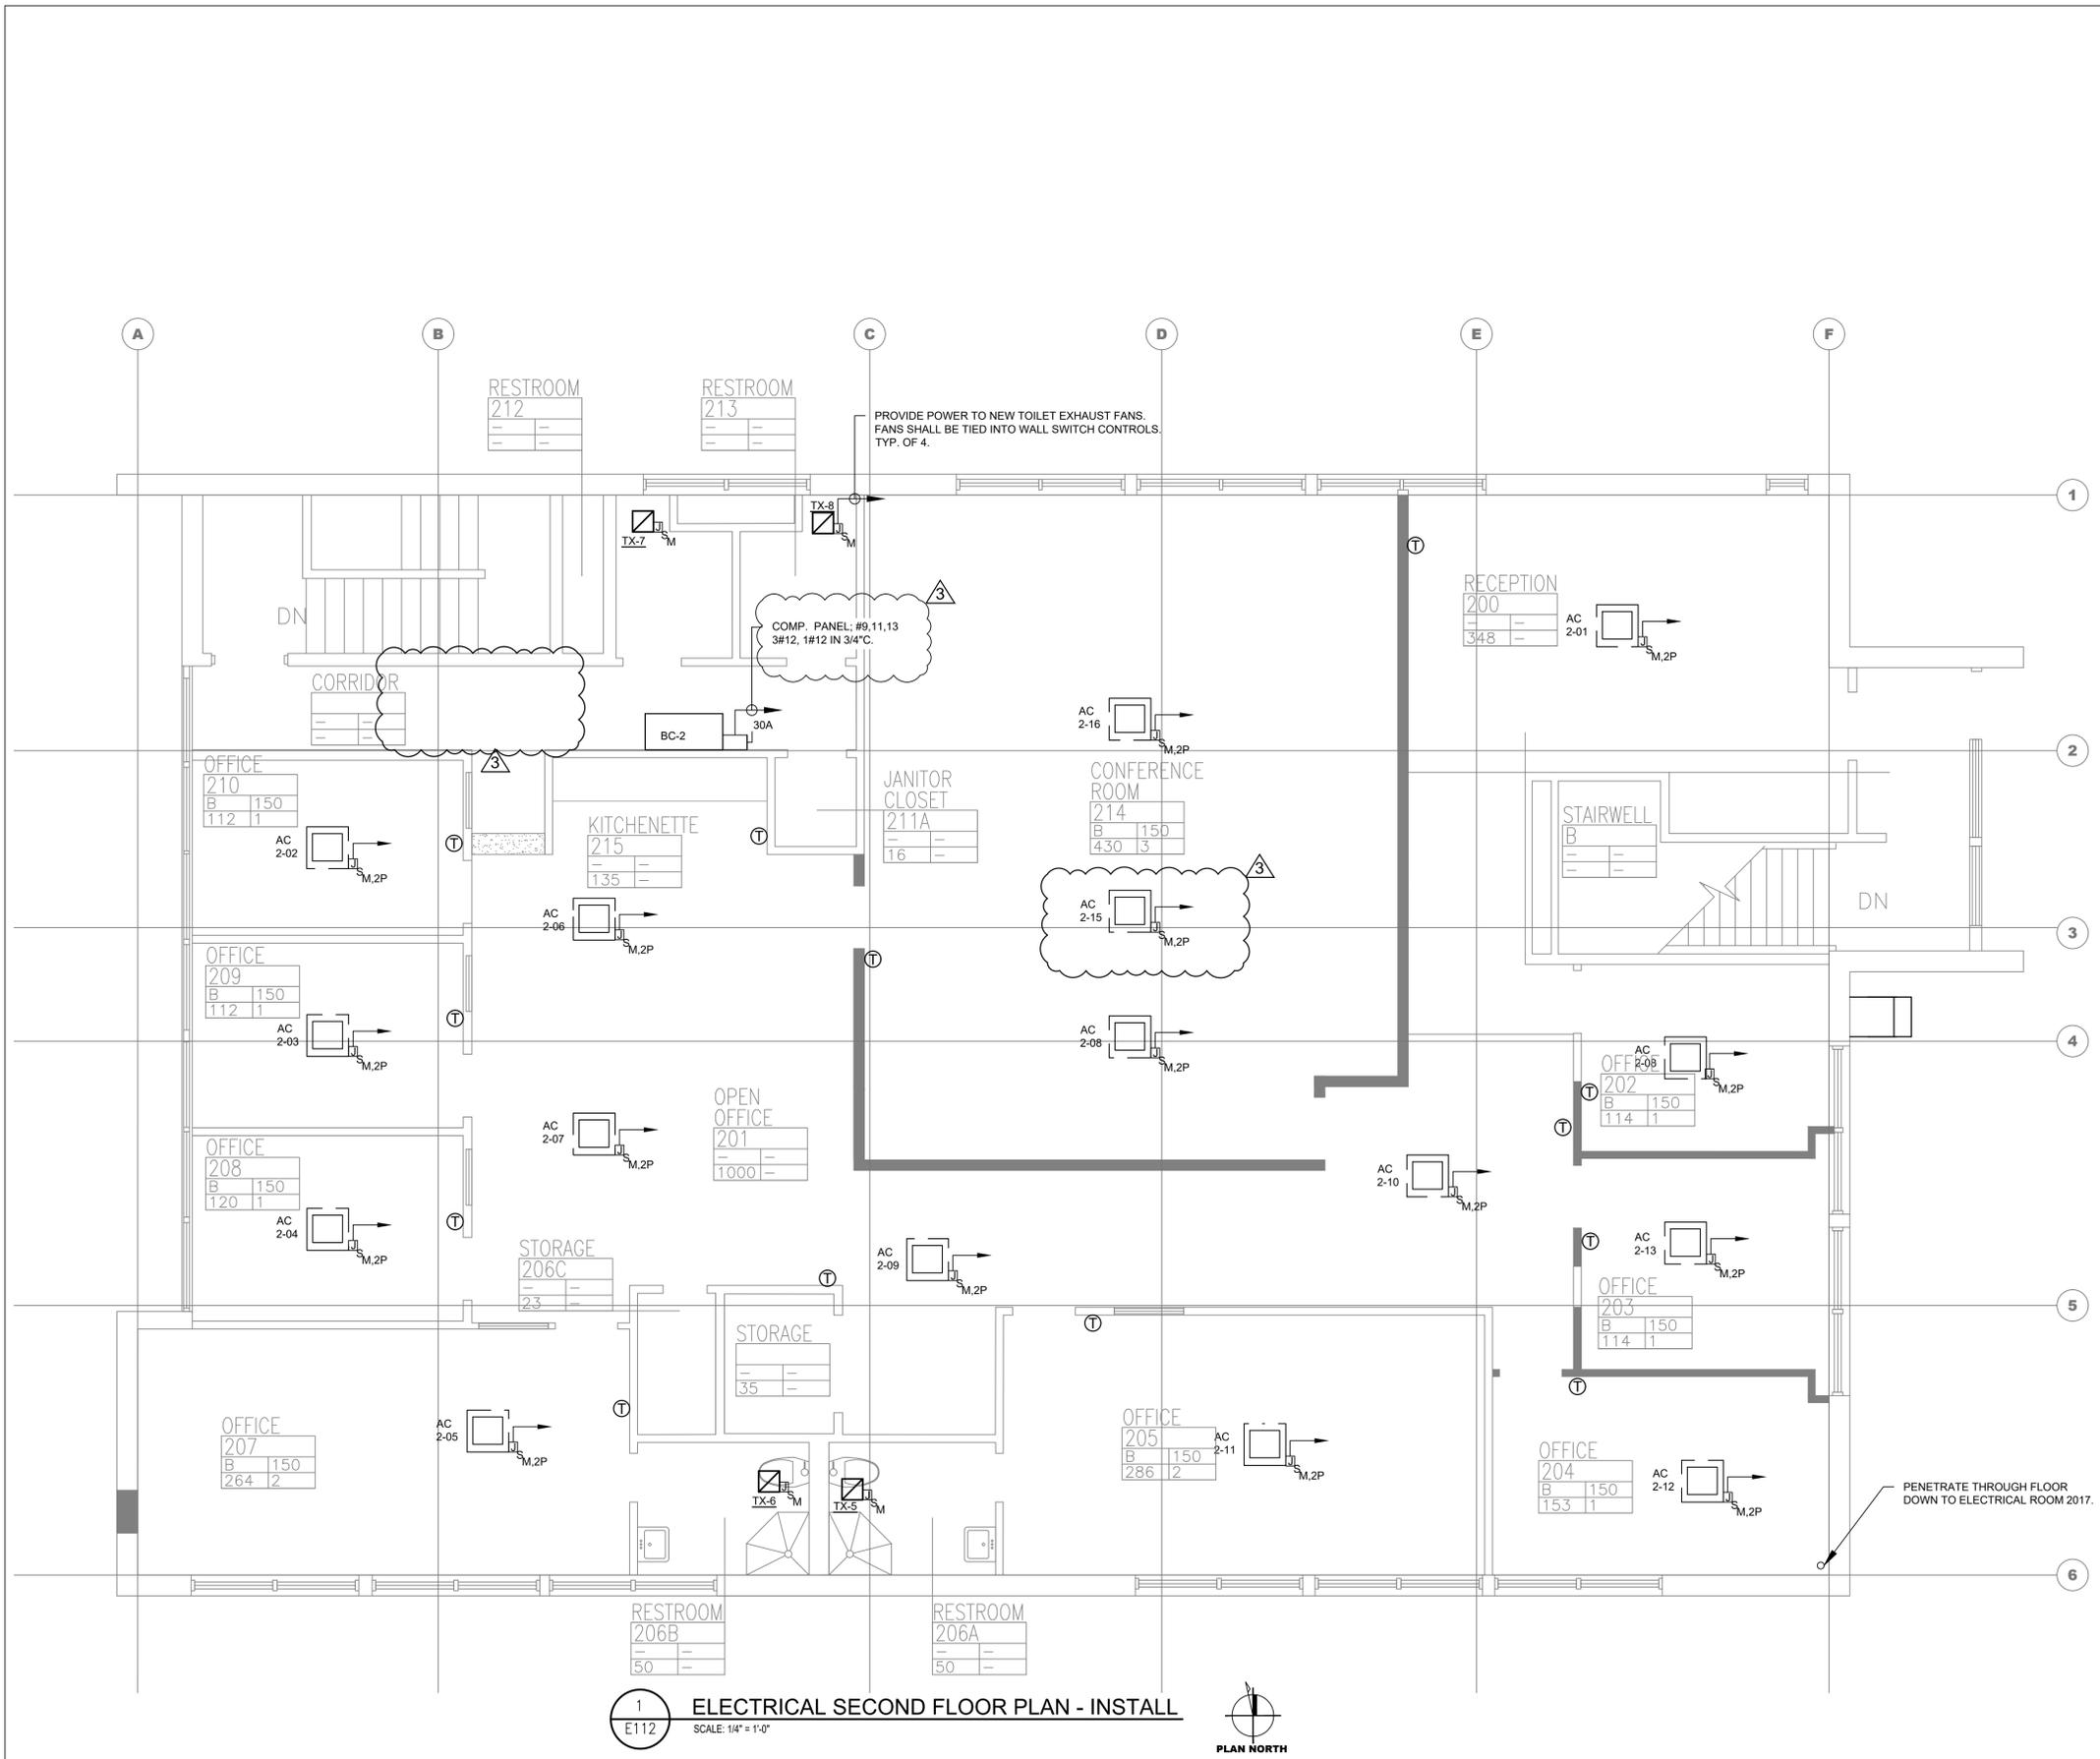

1  
E112  
**ELECTRICAL SECOND FLOOR PLAN - INSTALL**  
SCALE: 1/4" = 1'-0"  
PLAN NORTH

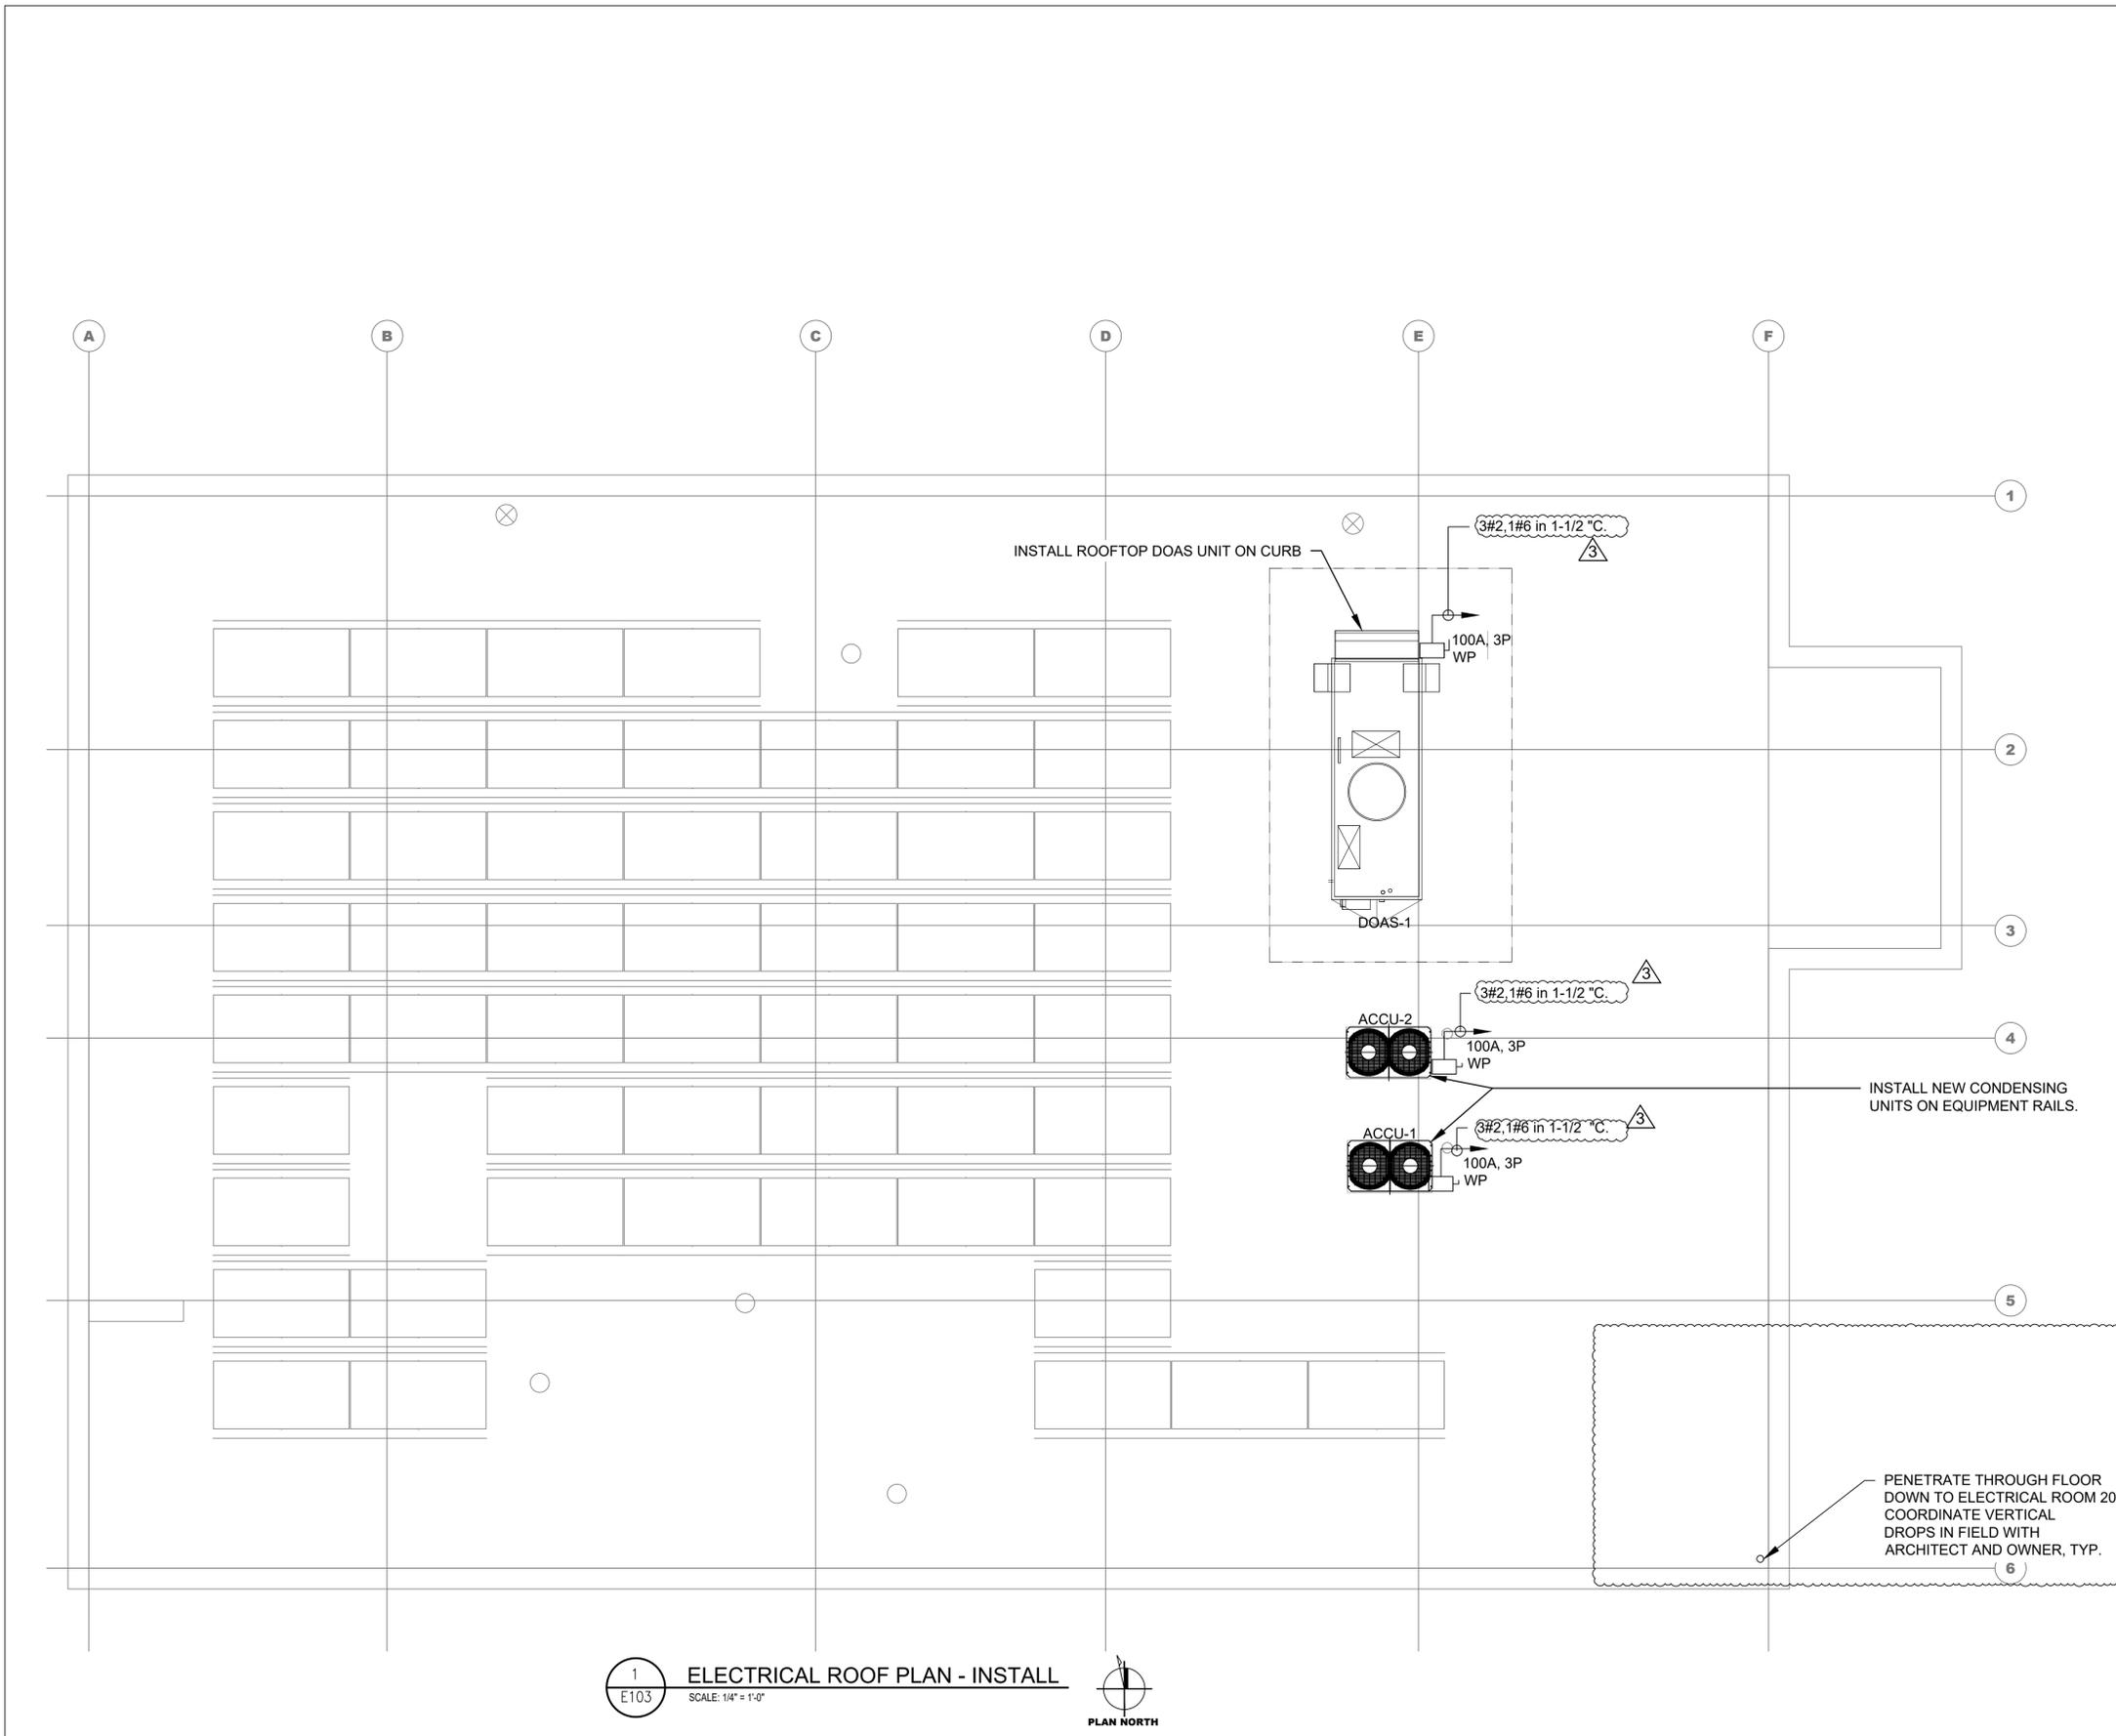

**PLAN NOTES:**

- FOR GENERAL NOTES, ABBREVIATIONS AND ELECTRICAL SYMBOLS, REFER TO DWG. E001.
- COORDINATE LOCATION OF BASE BUILDING ELECTRICAL PANELS WITH PROPERTY MANAGER.
- ALL WIRING SHALL BE #12 AWG, #12 AWG GND IN 3/4" C, U.O.N.
- CIRCUIT NUMBERS ARE FOR IDENTIFICATION PURPOSES ONLY.
- UPDATE ALL EXISTING PANELBOARD DIRECTORIES AFFECTED BY NEW WORK. REFER TO PANELBOARD DESIGNATION LEGEND FOR IDENTIFICATION OF PANELBOARDS AND CIRCUITS.
- CONTRACTOR SHALL MAINTAIN CONTINUITY TO ALL EXISTING CIRCUITRY TO REMAIN WHICH ARE AFFECTED BY THE SCOPE OF WORK; CONTRACTOR SHALL FURNISH ALL NECESSARY JUNCTION BOXES, CONDUIT, AND WIRES ARE REQUIRED.
- ALL OUTLET LOCATION AND MOUNTING HEIGHTS ARE PER ARCHITECT PLANS AND FIELD CONDITIONS, COORDINATE WITH ARCHITECT.
- REFER TO MECHANICAL AND PLUMBING PLANS FOR EQUIPMENT TO BE SUPPLIED BY OTHER TRADES AND INSTALLED/WIRED UNDER THIS SECTION. COORDINATE WITH MECHANICAL CONTRACTOR FOR THERMOSTAT LOCATIONS.
- ALL PENETRATIONS THROUGH FIRE RATED WALLS OR FLOORS SHALL BE SEALED TO PREVENT THE SPREAD OF SMOKE AND FIRE. THE FIRE RATING OF THE PENETRATION SEALING METHOD SHALL MATCH THE RATING OF THE WALL OR FLOOR. USE AN APPROVED SEALING METHOD WHICH IS ACCEPTABLE TO LOCAL JURISDICTION AND APPROVED BY UL.
- ALL NEW CONDUITS SHALL BE INSTALLED WITH AESTHETICS IN MIND. PAINT ALL NEW EXPOSED CONDUIT AND BOXES TO MATCH EXISTING CONDITIONS.
- PROVIDE DURA-BLOCK ROOF MOUNTED CONDUIT SUPPORTS OR APPROVED EQUIV.
- COORDINATE FINAL LOCATION OF ROOF RECEPTACLES IN FIELD WITH MECHANICAL INSTALLATIONS.

**SOLAR SYSTEM NOTES:**

- THE PROPOSED SOLAR PANEL LAYOUT IS FOR REFERENCE ONLY. CONTRACTOR SHALL VERIFY THAT THE SOLAR PANEL LAYOUT SHOWN MATCHES LATEST DESIGN GIVEN BY PHOTOVOLTAIC CONTRACTOR.
- IN THE EVENT THE PROPOSED LAYOUT SHOWN IS DIFFERENT THAN SHOWN, AMENDED, OR ALTERED BY SOLAR PANEL CONTRACTOR, CONTRACTOR SHALL NOTIFY GPI ENGINEERS TO VERIFY ALLOWABLE LOADS ON EXISTING STRUCTURE.
- REFER TO PUREPOWER PLANS/STRUCTURAL DRAWINGS FOR CALCULATED ADDITIONAL ALLOWABLE DEAD LOADS TO ASSIST IN THE DESIGN OF THE SOLAR PANEL LAYOUT. IN ADDITIONAL LOAD IS REQUIRED, GPI ENGINEERS SHALL BE NOTIFIED IMMEDIATELY.
- SOLAR PANELS REQUIRING MECHANICAL ATTACHMENTS SHALL BE FASTENED WITH OMG HEAVY DUTY ROOFING FASTENER (#14) SCREWS OR ENGINEER APPROVED EQUIVALENT. LENGTH SHALL BE ASSUMED TO BE 7", BUT SHALL BE FIELD VERIFIED TO FULLY ENGAGE ROOF DECK FOR EACH ATTACHMENT. CONTRACTOR SHALL REFER TO PANELCLAW DRAWINGS FOR DETAILS FOR SOLAR PANEL SUPPORTS & LAYOUT. CONTRACTOR SHALL FIELD TEST OMG HEAVY DUTY ROOFING FASTENER #14 WITH OMG FIELD REPRESENTATIVES FOR ADEQUATE PULL STRENGTH (>300 LBS) PRIOR TO COMPLETING INSTALLATION OF MECHANICAL ATTACHMENTS. IF PULL STRENGTH IS LESS THAN 300 LBS, GPI ENGINEERS SHALL BE NOTIFIED IMMEDIATELY.
- REFER TO PUREPOWER RENEWABLE ENERGY SOLAR PHOTOVOLTAIC SYSTEM DRAWINGS FOR ALL POWER DISTRIBUTION ONE LINE AND THREE LINE DRAWINGS. PROVIDE AND INSTALL ALL CONDUIT, WIRING, AND AUXILIARY COMPONENTS NECESSARY FOR A COMPLETE CODE COMPLIANT, FUNCTIONAL SYSTEM INSTALLATION.
- REFER TO ROOFTOP SOLAR LAYOUT DRAWINGS FOR THE SOLAR ARRAY LAYOUTS.
- COORDINATE ALL EQUIPMENT LAYOUT WITH PUREPOWER, THEIR SUB-CONSULTANTS AND THE OWNER PRIOR TO COMMENCING ANY WORK.
- ALL LABELING AND IDENTIFICATION OF THE NEW SOLAR ELECTRICAL EQUIPMENT SHALL BE PROVIDED AS PER NEC REQUIREMENTS.
- COORDINATE WITH THE ELECTRICAL UTILITY COMPANY FOR THE REPLACEMENT OF EXISTING UTILITY METER WITH NEW BIDIRECTIONAL METER, AS NECESSARY.



1  
E103  
**ELECTRICAL ROOF PLAN - INSTALL**  
SCALE: 1/4" = 1'-0"  
PLAN NORTH

No.	Date	Revisions
3	04-10-25	ADDENDUM NO. 3
0	02-18-25	RFF SET

Drawn by	JL
Checked by	SH
Project No.	40034G
Scale	
Date	02/18/2025

**GREENMAN PEDERSEN, INC**  
2 EXECUTIVE BOULEVARD  
SUITE 202  
SUFFERN, NY 10981

**ATZL NASHER, & ZIGLER**  
254 North Main Street  
New City, NY 10956

Mechanical, Electrical & Structural Engineer  
Civil Engineer

**RENOVATION OF ROCKLAND GREEN ADMINISTRATIVE HEADQUARTERS AND CONSTRUCTION OF AN IMMERSIVE THEATRE EXPERIENCE**

172 MAIN STREET  
NAUSETT, NY 10964

TOWN OF CLARINGTON  
COUNTY OF ROCKLAND

**MSA**

**MICHAEL SHILALE ARCHITECTS, LLP**  
140 Park Avenue New City, NY 10956 Tel: 845-708-9200  
www.shilale.com

© COPYRIGHT, MICHAEL SHILALE ARCHITECTS, ALL RIGHTS RESERVED.

Drawing Title  
**ELECTRICAL ROOF PLAN - INSTALLATION**

Drawing No.  
**E103**

WILLIAM STREET

POWER POLE

PROPOSED LOCATION FOR 150KW NATURAL GAS GENERATOR IN LEVEL 2 ENCLOSURE.

[ATS] WP

ELECTRICAL SERVICE ROOM LOCATED AT 1ST FLOOR LEVEL OF BUILDING

TWO STORY BRICK BUILDING

DEMAREST AVENUE

0 1/2 1  
IF THIS BAR DOES NOT MEASURE 1" THEN DRAWING IS NOT TO FULL SCALE

No.	Date	Revisions
3	04-10-25	ADDENDUM NO. 3
0	02-18-25	RFP SET

--	--	--

Drawn by	JL
Checked by	SH
Project No.	40034G
Scale	AS SHOWN
Date	02/18/2025

Mechanical, Electrical & Structural Engineer:	<b>GREENMAN PEDERSEN, INC</b> 2 EXECUTIVE BOULEVARD SUITE 202 SPRINGFIELD, NY 10901
Civil Engineer:	<b>ATZL, NASHER, &amp; ZIGLER</b> 254 North Main Street New City, NY 10956

**RENOVATION OF ROCKLAND GREEN ADMINISTRATIVE HEADQUARTERS AND CONSTRUCTION OF AN IMMERSIVE THEATRE EXPERIENCE**

172 MAIN STREET  
NAUTLET, NY 10964

TOWN OF CLANSTON,  
COUNTY OF ROCKLAND



**MICHAEL SHILALE ARCHITECTS, LLP**  
140 Park Avenue New City, NY 10956 Tel 845-708-9200  
www.shilale.com


Drawing Title	<b>ELECTRICAL SITE PLAN</b>
Drawing No.	<b>E104</b>

1  
E104  
SCALE: 1/8" = 1'-0"




**PLAN NOTES:**

- ANY UTILITY SHOWN ON PLANS ARE BASED ON OBSERVATION AT THE SURFACE LEVEL ONLY. THE CONTRACTOR SHALL PROVIDE TONE-OUT/UTILITY LOCATING SERVICES PRIOR TO COMMENCING EXCAVATION IN ANY WORK AREAS.

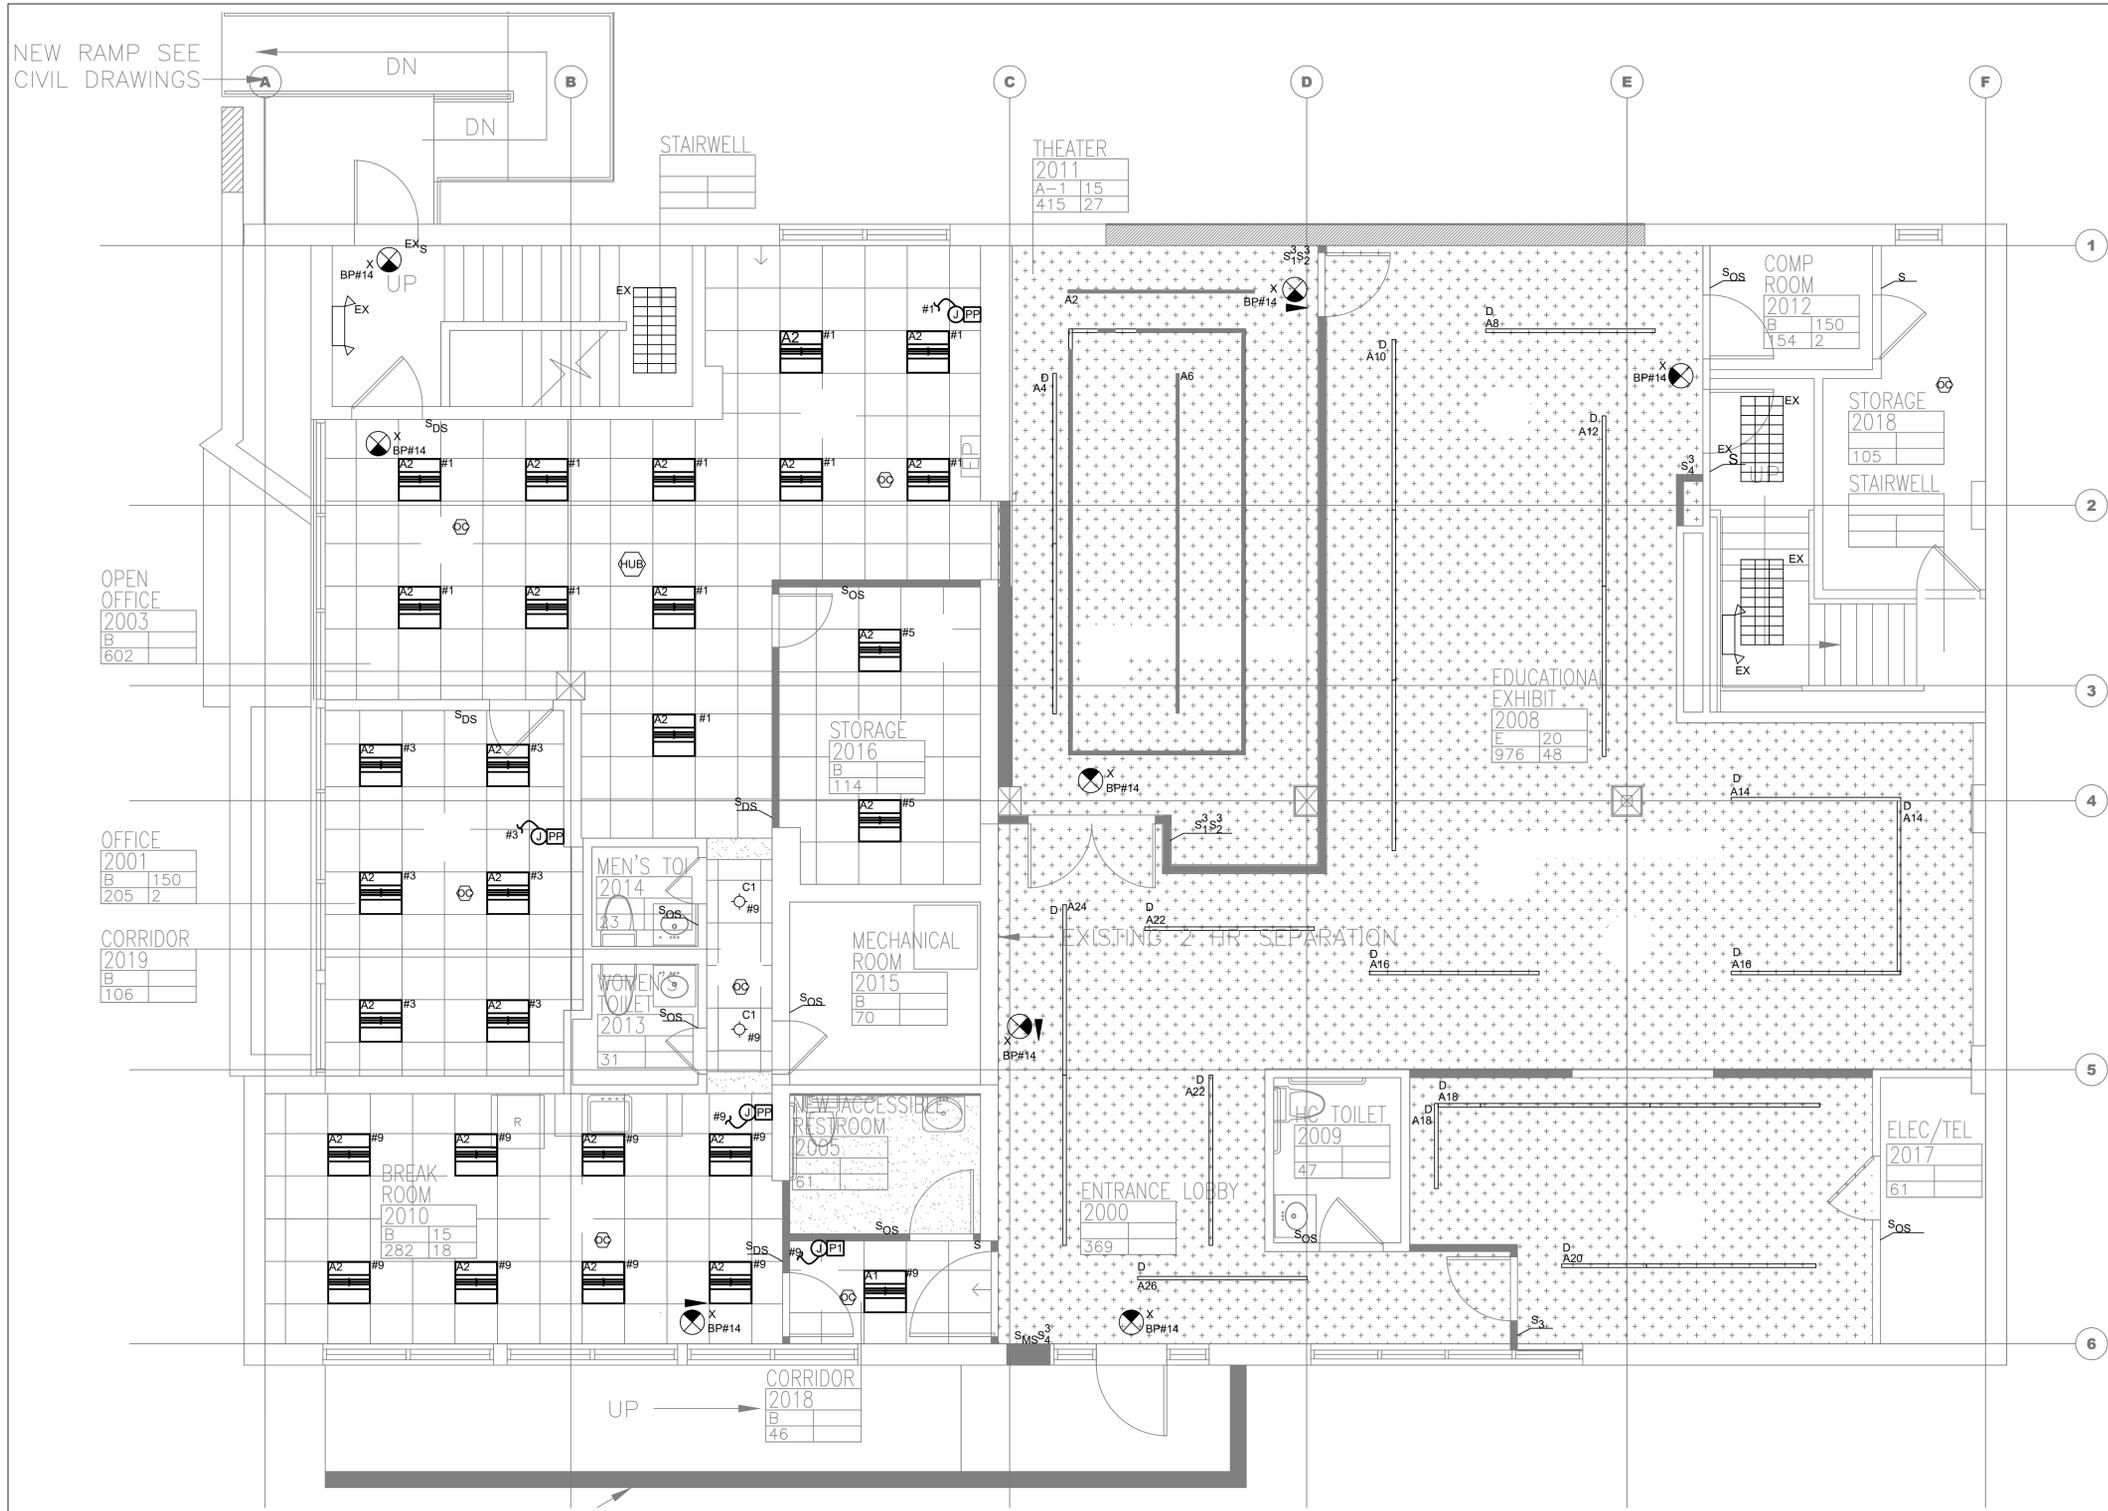

**PLAN NOTES:**

- FOR GENERAL NOTES, ABBREVIATIONS AND ELECTRICAL SYMBOLS, REFER TO DWG. E001.
- COORDINATE LOCATION OF BASE BUILDING ELECTRICAL PANELS WITH PROPERTY MANAGER.
- ALL WIRING SHALL BE 2#12 AWG, 1#12 AWG GND IN 3/4" C, U.O.N.
- CIRCUIT NUMBERS ARE FOR IDENTIFICATION PURPOSES ONLY.
- UPDATE ALL EXISTING PANELBOARD DIRECTORIES AFFECTED BY NEW WORK. REFER TO PANELBOARD DESIGNATION LEGEND FOR IDENTIFICATION OF PANELBOARDS AND CIRCUITS.
- CONTRACTOR SHALL MAINTAIN CONTINUITY TO ALL EXISTING CIRCUITRY TO REMAIN WHICH ARE AFFECTED BY THE SCOPE OF WORK; CONTRACTOR SHALL FURNISH ALL NECESSARY JUNCTION BOXES, CONDUIT, AND WIRES ARE REQUIRED.
- ALL OUTLET LOCATION AND MOUNTING HEIGHTS ARE PER ARCHITECT PLANS AND FIELD CONDITIONS, COORDINATE WITH ARCHITECT.
- ALL DATA CABLING TO BE BY SYSTEMS VENDOR; COORDINATE LOCATIONS/ROUTING WITH CABLING VENDOR. REFER TO DWG. E203 FOR LIGHTING CONTROL DEVICE WIRING DIAGRAM INFORMATION. REFER TO WHIRLWIND CREATIVE WIRING DIAGRAM FOR THEATER AND EXHIBIT SPACE LIGHTING REQUIREMENTS.
- EXTERIOR 150KW GENERATOR SHALL PROVIDE POWER THE ENTIRE BUILDING (INCLUDING LIGHTING) IN THE EVENT OF POWER LOSS. PROVIDE ALL EXIT SIGNS ON SAME CKT.
- UTILIZE PANEL PP-1 (RX) AND PANEL BP-1(BP#X) TO ENERGIZE ALL LIGHTING CIRCUIT(S) IN AREA OF WORK, U.O.N. PROVIDE NEW LIGHTING CONTROLS AS INDICATED.
- PROVIDE DAYLIGHT HARVESTING CONTROLS WHERE REQUIRED. NEW CONTROLS SHALL BE WIRELESS. CONTRACTOR SHALL PROVIDE SYSTEM THAT INCLUDES A HUB, CEILING MOUNTED OCCUPANCY/VACANCY/PHOTO SENSORS, POWER PACKS, WALL SWITCHES AND ALL ANCILLARY COMPONENTS AS REQUIRED FOR A COMPLETE SYSTEM INSTALLATION. COORDINATE ADDITIONAL REQUIREMENTS WITH APPROVED SYSTEM MANUFACTURER. REFER TO E203 FOR ADDITIONAL INFORMATION.
- VERIFY LOCATION OF LIGHTING MANAGEMENT HUB, MODEL OP6 IN FIELD WITH LIGHTING VENDOR, AV VENDOR AND FIELD CONDITIONS.
- EXHIBIT 2008, ENTRANCE LOBBY 2000 AND THEATER 2011 SHALL BE PROVIDED WITH TIME-SWITCH CONTROLS THAT MEET 2020 NYS ENERGY CONSERVATION CODE REQUIREMENTS. COORDINATE PROGRAMMING OF LIGHTING CONTROL EQUIPMENT WITH VENDOR AND BUILDING REPRESENTATIVE.

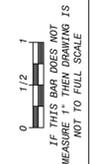

No.	Date	Revisions
3	04-10-25	ADDENDUM NO. 3
0	02-18-25	RFF SET

Drawn by	JL
Checked by	SH
Project No.	40034G
Scale	
Date	02/18/2025

<b>GREENMAN PEDERSEN, INC</b> 2 EXECUTIVE BOULEVARD SUITE 202 SUNBURG, NY 10891	<b>ATZLNASHER, &amp; ZIGLER</b> 204 North Main Street New City, NY 10956
Mechanical & Structural Engineer	Civil Engineer

**RENOVATION OF ROCKLAND GREEN ADMINISTRATIVE HEADQUARTERS AND CONSTRUCTION OF AN IMMERSIVE THEATRE EXPERIENCE**  
TOWN OF ROCKLAND, COUNTY OF ROCKLAND  
172 MAIN STREET, NAUTLET, NY 10964



© COPYRIGHT, MICHAEL SHILALE ARCHITECTS, ALL RIGHTS RESERVED.  
Drawing Title: **ELECTRICAL FIRST FLOOR RCP -INSTALLATION**  
Drawing No.: **E201**

**1 ELECTRICAL FIRST FLOOR PLAN - INSTALL**  
E201 SCALE: 1/4" = 1'-0"




SYMBOL	DESCRIPTION	MANUFACTURER	MODEL NUMBER	WATTS	LUMENS	LLF
A1	2 X 2 LINEAR LED LIGHT FIXTURE	ELITE	22-EDGE-LED-4000L-DIM10-MVOLT-35K-85	41.3	4261	0.900
A2	2 X 2 LINEAR LED LIGHT FIXTURE	ELITE	22-EDGE-LED-3000L-DIM10-MVOLT-35K-85	29.6	3196	0.900
A3	2 X 2 LINEAR LED LIGHT FIXTURE	ELITE	22-EDGE-LED-2000L-DIM10-MVOLT-35K-85	19.1	2086	0.900
B1	4" DIA. RECESSED DOWNLIGHT	ELITE	HH4-LED-1500L-DIM10-MVOLT-WD-35K-90-HH4-4501-CL-WH	20	1494	0.850
C1	6" DIA. RECESSED DOWNLIGHT	ELITE	HH6-LED-2000L-DIM10-MVOLT-WD-40K-90-HH6-6501-CL-WH	22.7	2013	0.900
D	TRACK LIGHTING	TIME SQUARE LIGHTING	TRACK: SINGLE CIRCUIT 120V TRACK TRACK LIGHT: SB30 LAMP: SORRA VIVID PAR30S, E26 LAMP	18.5 / LAMP		
X	EDGE-LIT LED EXIT SIGN (GREEN)	COMPASS	CEL-R1/R2-G-NE	2.94		



**ADDITIONAL NOTES:**

- CONTRACTOR TO VERIFY QUANTITY AND TYPE OF ALL FIXTURES AND ASSOCIATED DRIVERS IN FIELD.
- COORDINATE WITH MANUFACTURERS FOR ALL ANCILLARY COMPONENTS REQUIRED FOR FIXTURES WITH 0-10V DIMMING REQUIREMENTS.
- PROVIDE FIXTURE D WITH ALL ANCILLARY COMPONENTS REQUIRED FOR FULL TRACK LIGHT FIXTURE INSTALLATION. PROVIDE LAMP WITH ECOSENSE SNAP SYSTEM ACCESSORIES; COORDINATE REQUIREMENTS WITH ARCHITECT.

SECOND FLOOR

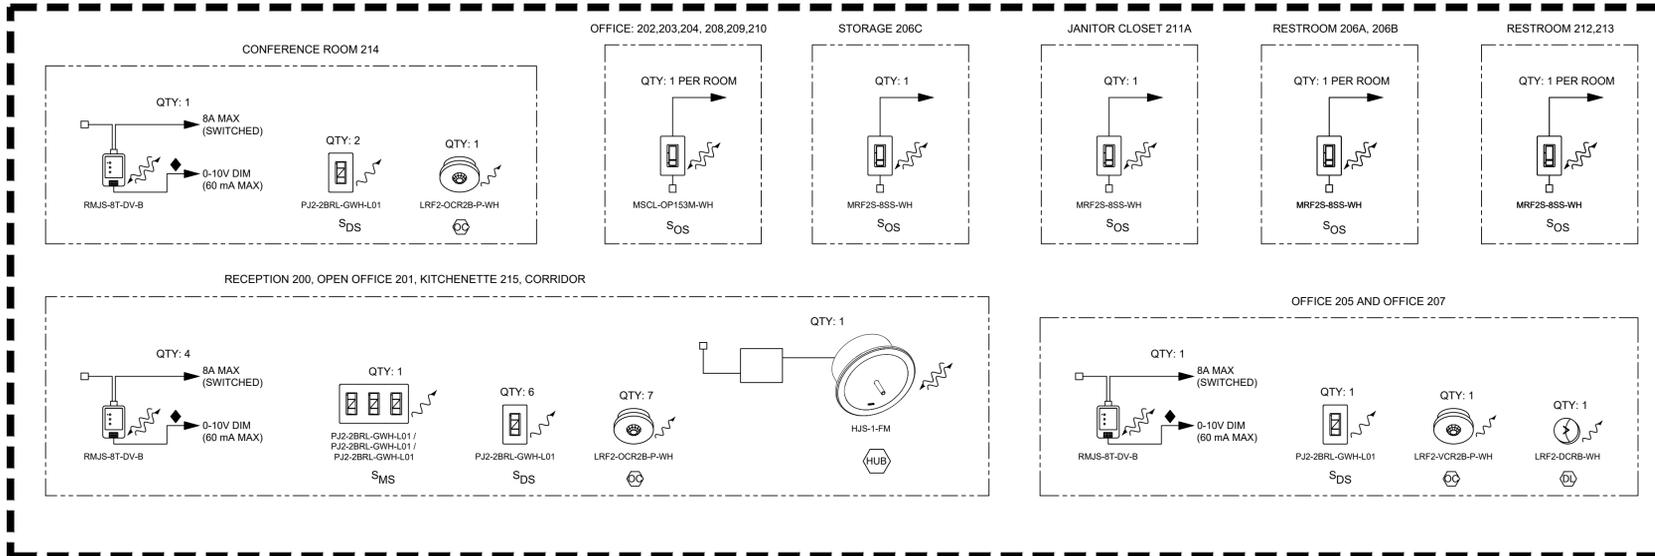

FIRST FLOOR

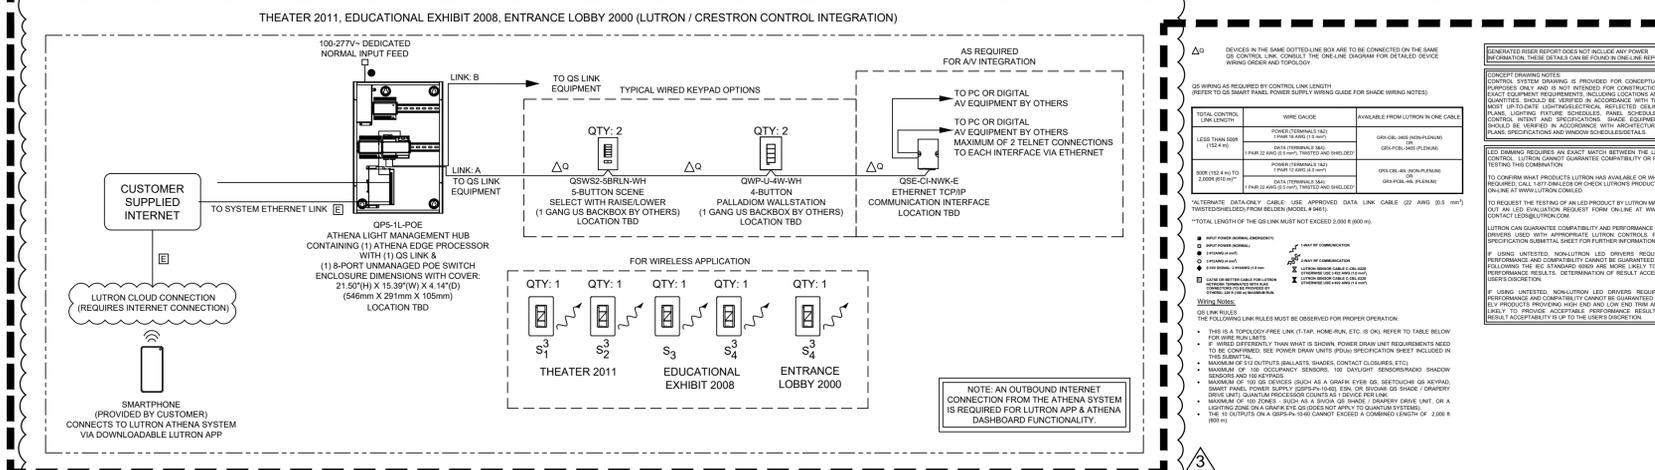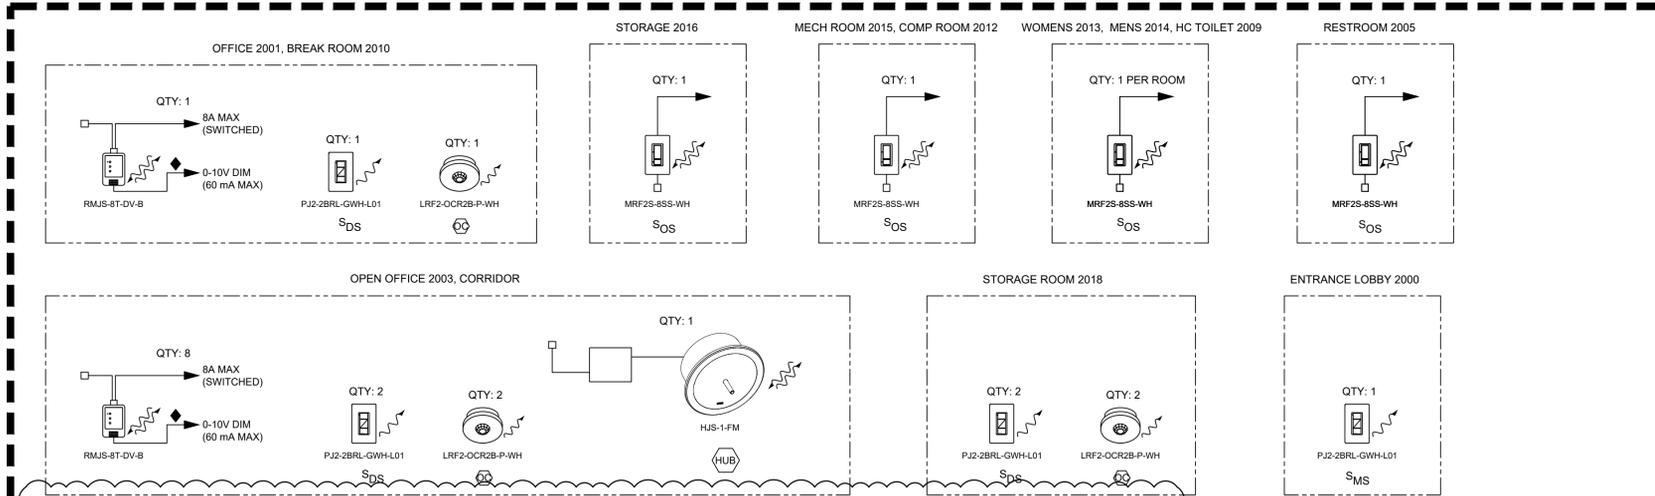

DYNAMIC RISER DIAGRAM

**GENERAL NOTES**

- REFER TO SUBMITTAL SYSTEM LAYOUT REPORT AND ONE-LINE (IF AVAILABLE) FOR DEVICE WIRING INFORMATION AND DETAILS. OBTAIN DOCUMENTS FROM APPROVED SYSTEM MANUFACTURER.
- REFER TO PANEL AND FIXTURE SCHEDULES FOR ADDITIONAL LOAD INFORMATION.
- REFER TO SUBMITTAL SYSTEM LAYOUT OR LOOP SCHEDULE REPORTS FOR MORE INFORMATION ABOUT FIXTURES ON THE DIGITAL LOOP.
- PROVIDE LUTRON MANUFACTURER RECOMMENDED DIMMING CONTROL PACKAGE COMPATIBLE FOR SEAMLESS INTEGRATION WITH CRESTRON SYSTEM CONTROLS. FOR THE THEATER AND EXHIBIT SPACE, PROVIDE ALL REQUIRED SWITCHES, MODULES, AND ANCILLARY DEVICES AS REQUIRED FOR THEATER AND EXHIBIT SPACE LIGHTING CONTROLS. FINAL DIMMING CONTROLS PACKAGE SHALL BE BY LUTRON IN COLLABORATION WITH CRESTRON.

LUTRON SERVICES

SERVICE TITLE (MODEL NUMBER)	SERVICE DESCRIPTION
QTY: 1	PRE-STARTUP ELECTIVE SERVICES
1	PRE-STARTUP ELECTIVE SERVICES
1	POST-STARTUP ELECTIVE SERVICES
1	MINTENANCE & SUPPORT SERVICES

No.	Date	Revisions
3	04-10-25	ADDENDUM NO. 3
0	02-18-25	RFF SET

Drawn by: JL  
 Checked by: SH  
 Project No.: 40034C  
 Scale: NONE  
 Date: 02/18/2025

GREENMAN PEDERSEN, INC.  
 2 EXECUTIVE BOULEVARD  
 SUITE 202  
 SUDBURY, NY 10861

ATZL NASHER, & ZIGLER  
 254 North Main Street  
 New City, NY 10954

Mechanical, Electrical, Structural Engineer  
 Civil Engineer

RENOVATION OF ROCKLAND GREEN ADMINISTRATIVE HEADQUARTERS AND CONSTRUCTION OF AN IMMERSIVE THEATRE EXPERIENCE

172 MAIN STREET  
 ROCKLAND COUNTY OF ROCKLAND, NY 10954

MICHAEL SHILALE ARCHITECTS, LLP  
 140 Park Avenue New City, NY 10959 Tel 845-708-9200  
 www.shilale.com

© COPYRIGHT, MICHAEL SHILALE ARCHITECTS. ALL RIGHTS RESERVED.

Electrical Lighting Controls

Drawing No. E203







**GENERAL NOTES:**

- ALL WIRING, POWER, CONDUCTORS, CONDUITS ETC. SHALL MEET CURRENT NANUET, NY BUILDING CODE REQUIREMENTS.
- ALL WORK SHALL BE IN ACCORDANCE WITH THE 2020 NYS BUILDING CODE, 2020 NYS UNIFORM CODE, CHAPTER 70, NFPA 72, NFPA 720, NFPA 70, AND 2020 NEC.
- COMPLETE FIRE ALARM INSTALLATION SHALL COMPLY WITH THE LATEST REQUIREMENTS OF ADA AND UL.
- ALARM CIRCUITS SHALL BE SIZED TO A MAXIMUM OF 80% CAPACITY.
- ALL FIRE ALARM EQUIPMENT SHALL BE INSTALLED WITH AESTHETICS IN MIND, AS FOLLOWS: PAINT ALL NEW CONDUIT AND BOXES TO MATCH EXISTING CONDITIONS, PATCH AND PAINT LOCATIONS OF REMOVED BOXES TO MATCH EXISTING.
- MINIMUM CONDUIT SIZE 3/4". TYPE OF RACEWAY SHALL BE EMT. SIZE AND TYPE OF WIRE SHALL BE AS PER MANUFACTURER'S REQUIREMENTS AND AS APPROVED BY AUTHORITIES HAVING JURISDICTION, U.O.N.
- ALL DEVICE WIRING SHALL BE SUPERVISED SO THAT THE FACP WILL BE NOTIFIED IN THE EVENT OF ANY RUPTURE/BREAK IN THE WIRE.
- LOCATION OF DEVICES AND EQUIPMENT ARE APPROXIMATE. FINAL LOCATIONS MUST BE DETERMINED ACCORDING TO THE SITE CONDITIONS.
- DEVICES AND EQUIPMENT ARE SHOWN DIAGRAMMATIC. SIZES AND LOCATION OF EQUIPMENT AND WIRING ARE SHOWN TO SCALE WHERE POSSIBLE, BUT MAY BE DISTORTED FOR CLARITY ON THE DRAWINGS. FINAL LOCATION OF EQUIPMENT SHALL BE AS APPROVED BY THE ARCHITECT OR THEIR REPRESENTATIVE. IT IS NOT WITHIN THE SCOPE OF DRAWINGS TO SHOW ALL NECESSARY BENDS, OFFSETS, PULL BOXES AND OBSTRUCTIONS. IT SHALL BE THE RESPONSIBILITY OF CONTRACTOR TO INSTALL HIS WORK TO CONFORM TO THE STRUCTURE, PRESERVE HEADROOM AND KEEP OPENINGS AND PASSAGEWAYS CLEAR.
- CONTRACTOR SHALL VISIT AND CAREFULLY EXAMINE THE AREAS AFFECTED BY THIS WORK TO BECOME FAMILIAR WITH EXISTING CONDITIONS AND WITH THE DIFFICULTIES THAT WILL ATTEND THE EXECUTION OF THIS WORK.
- VERIFY LOCATIONS AND QUANTITY OF ALL EQUIPMENT WITH DRAWINGS OR INTERIOR DETAILS. IN LOCATING BOXES OR DEVICES, ALLOW FOR OVERHEAD PIPES, DUCTS, MECHANICAL EQUIPMENT, VARIATIONS IN FIREPROOFING AND PLASTERING, WINDOW AND DOOR TRIM, PANELING, HUNG CEILING, ETC., AND CORRECT ANY INACCURACY WITHOUT ADDITIONAL EXPENSE TO OWNER.
- DIVISION 26 CONTRACTOR IS RESPONSIBLE FOR ALL POWER CONNECTIONS. DIVISION 28 CONTRACTOR IS RESPONSIBLE FOR LOW-VOLTAGE AND FIRE ALARM MODULE CONNECTIONS.
- THESE DRAWINGS WERE PREPARED FROM AVAILABLE INFORMATION PROVIDED BY THE OWNER AND FIELD SURVEY INFORMATION COMPILED BY THE ENGINEER FOR THE PURPOSE OF ENGINEERING DESIGN. CONTRACTOR SHALL VERIFY ALL DIMENSIONS, ELEVATIONS, LOCATIONS, SIZES AND CONDITIONS AT THE SITE, INCLUDING EXAMINING ANY SUBSTRATES, AND REPORT ANY DISCREPANCIES TO THE ENGINEER PRIOR TO BEGINNING INSTALLATION OR FABRICATION OF THE WORK.
- CONTRACTOR SHALL MAINTAIN ORDERLY HOUSEKEEPING DURING CONSTRUCTION, AND UPON SUBSTANTIAL COMPLETION, PERFORM FINAL CLEANUP. CONTRACTOR SHALL REMOVE ALL CONSTRUCTION RUBBISH, SCAFFOLDING, EQUIPMENT, TEMPORARY PROTECTION, TEMPORARY FIELD STRUCTURES, AND OTHER MATERIALS OR EQUIPMENT THAT WAS REQUIRED IN CONNECTION WITH THE WORK, BUT NOT A PERMANENT PART THEREOF.
- CONTRACTOR SHALL PROVIDE A DRAWING AT THE MAIN FACP SHOWING THE LOCATIONS OF ALL FIRE ALARM DEVICES.
- ALL FIRE ALARM CIRCUITS SHALL BE WIRED NFPA STYLE 4Y/B (CLASS B) WITH THE EXCEPTION OF THE NETWORK CIRCUIT WHICH SHALL BE NFPA STYLE 7 (CLASS A WITH ISOLATION). DUAL CLASS B NETWORKING IS NOT STYLE 7 AND WILL NOT BE APPROVED. ALL AUDIBLE AND VISUAL CIRCUITS SHALL BE STYLE Y/CLASS B UNLESS THE CONTRACT DRAWINGS INDICATE NYC SPLIT A/B. A/B CIRCUITS SHALL BE WIRED SO THAT EVERY OTHER DEVICE IS WIRED ON AN ALTERNATE CIRCUIT.
- CONDUITS MAY NOT ENTER THE TOP OF ANY FIRE ALARM CONTROL EQUIPMENT CABINET.
- PATCH AND PAINT LOCATIONS OF REMOVED BOXES TO MATCH EXISTING, RESTORE SURFACES TO ORIGINAL CONDITIONS. REFER TO ARCHITECTURAL DETAILS.
- ALL FIRE ALARM CABINETS AND JUNCTION BOXES SHALL BE PAINTED FIRE DEPARTMENT RED. FIRE ALARM CABINETS SHALL BE CLEARLY LABELED WITH A NY APPROVED LAMINATE ENGRAVED LABEL.
- ALL FIRE ALARM WIRE SHALL BE CLEARLY LABELED IN JUNCTION BOXES AND CABINETS. ALL TERMINALS SHALL BE NUMBERED AND LABELED. ALL CONNECTIONS SHALL BE EITHER SOLDERED, APPROVED TERMINAL STRIPS, APPROVED WIRE NUTS (APPROVED TEMPERATURE), OR SCOTCH LOCKS.
- ALL LOW VOLTAGE FIRE ALARM CONDUCTORS SHALL BE PROTECTED BY EITHER BUILDING CONSTRUCTION OR CONDUIT TO 8 FEET ABOVE THE FINISHED FLOOR. MECHANICAL AND ELECTRICAL ROOMS, AND OTHER LOCATIONS SUBJECT TO MECHANICAL DAMAGE SHALL BE IN FULL RIGID CONDUIT. IN ALL OTHER AREAS, NYC APPROVED WIRE MAY BE RUN WITHOUT CONDUIT ABOVE 8 FT. PROVIDED IT MEETS NYS CODES AND CONNECTS TO BUILDING CONSTRUCTION USING NYS APPROVED MEANS.
- FIRE ALARM CABLES SHALL NOT BE MIXED WITH NON FIRE ALARM CABLING. LOW VOLTAGE FIRE ALARM CABLING SHALL NOT BE MIXED OR WIRED NEAR ANY AC CIRCUIT.
- ALL WIRING FOR FIRE ALARM SYSTEM SHALL BE FLUOROPOLYMER "TEFLON" TYPE CABLING AND SHALL MEET THE REQUIREMENTS UL 1424 AND UL 910 AS FOLLOWS:
- ALL NOTIFICATION CIRCUITS SHALL BE A MINIMUM OF 14 AWG AND ALL OTHER LOW VOLTAGE FIRE ALARM CIRCUITS SHALL BE 16 AWG MINIMUM.
- POLARITY SHALL BE OBSERVED ON ALL CIRCUITS. T-TAPPING SHALL NOT BE ALLOWED ON ANY NOTIFICATION CIRCUITS (HORN, STROBE OR SPEAKER). T-TAPPING SHALL NOT BE PERMITTED ON ADDRESSABLE CIRCUITS WITHOUT THE EXPRESS PERMISSION OF THE ENGINEER.
- ALL WIRING SHALL BE INSPECTED TO ASSURE THERE ARE NO OPENS, SHORTS OR EARTH GROUNDS.
- SHIELDED CONDUCTORS OR RUNNING IN SEPARATE RACEWAY SHALL BE AS INSTRUCTED BY THE FIRE ALARM MANUFACTURER'S DOCUMENTATION. ALL NON-POWER LIMITED WIRING, INCLUDING CIRCUITS FOR NON POWER LIMITED CENTRALIZED AMPLIFIERS SHALL BE RUN IN A SEPARATE RACEWAY.

- ALL REMOTE FIRE ALARM CONTROL CABINETS (DATA GATHERING PANELS (DGP), TT(B/S), FARAS, ETC.) SHALL INCLUDE AN INTERNAL TAMPER EACH SHALL ALSO INCLUDE A SMOKE DETECTOR MOUNTED ON THE CEILING DIRECTLY ABOVE IT SHOULD ONE OR MORE NOT ALREADY BE SHOWN ON THE PLANS IN THE ROOM THAT IT IS MOUNTED IN.
- ALL CEILING MOUNT DEVICES MUST BE SECURELY FASTENED TO BUILDING CONSTRUCTION FROM SLAB ABOVE.
- LOCATION OF DEVICES AND EQUIPMENT ARE APPROXIMATE. FINAL LOCATIONS MUST BE DETERMINED ACCORDING TO THE SITE CONDITIONS. DEVICE LOCATIONS MUST BE READILY ACCESSIBLE TO ALLOW FOR MAINTENANCE AND REPAIR.
- ALL AREA SMOKE DETECTORS SHALL BE PHOTO-ELECTRIC TYPE.
- SMOKE DETECTORS MUST BE MOUNTED AT LEAST 3 FT AWAY FROM ANY AIR REGISTER.
- COMBINATION SMOKE AND CO DETECTORS SHALL BE FULLY ADDRESSABLE AND INCLUDE A SOUNDER BASE, EACH WITH AN INTERNAL SYNCHRONIZED TEMPORAL 3 AND 4 SOUNDERS, AND THE NECESSARY MONITORING DEVICES. IF POWERED SEPARATELY (24VDC), POWER TO THE DEVICE SHALL ALSO BE SUPERVISED.
- MANUAL PULL STATION(S) SHALL BE MOUNTED 48 INCHES ABOVE THE FINISHED FLOOR TO MEET ADA HEIGHT REQUIREMENT. DEVICE SHALL BE PAINTED FIRE DEPARTMENT RED. ALL MANUAL STATIONS SHALL BE INSTALLED SO THAT THEY ARE KEPT UN-OBSTRICTED FROM OTHER BUILDING CONSTRUCTION.
- ALL STROBE LIGHTS SHALL BE UL-1971 APPROVED/LISTED. THE MINIMUM CANDELA IS 15 UNLESS OTHERWISE NOTED. STROBES SHALL BE SHALL HAVE MINIMUM 5'-0" CLEARANCE FROM ANY OF OBSTRUCTIONS. A 15/75 STROBE MAY BE UTILIZED WHERE 15 CANDELA STROBES MEET NFPA REQUIREMENTS (CORRIDORS AND 20 X 20 SPACES). STROBES SHALL BE SYNCHRONIZED AT LINE OF SITE.
- NOTIFICATION DEVICES THAT INCLUDE A STROBE SHALL BE MOUNTED SUCH THAT THE ENTIRE LENS IS NOT LESS THAN 80 IN. AND NOT GREATER THAN 96 IN. ABOVE THE FINISHED FLOOR, U.O.N. WHERE LOCAL CONDITIONS DIFFER INSTALL THE STROBES AND/OR HORNS AT 6" BELOW THE CEILING.
- ALL AUXILIARY RELAYS F SHALL BE WIRED A MAXIMUM OF 3 FT FROM THE CONTROLLED DEVICE. THE AUXILIARY RELAY SHALL FUNCTION WITHIN THE REQUIRED VOLTAGE AND CURRENT OF THE CONTROLLED INTERPOSING RELAYS SHALL BE INCLUDED AND POWERED BY THE FIRE ALARM CONTROL PANEL IN A FAIL-SAFE (FIRE FUNCTION) POSITION. POWER TO THE INTERPOSING RELAY SHALL BE MONITORED BY THE FIRE ALARM SYSTEM.
- EACH FIRE ALARM INITIATING AND INDICATING CIRCUIT SHALL BE ELECTRICALLY SUPERVISED.
- A CENTRAL STATION DIALER AND TWO DEDICATED PHONE LINES SHALL BE PROVIDED. THE DIALER SHALL BE CAPABLE OF SENDING THE FOLLOWING EVENTS: ALARM, MANUAL STATION, SUPERVISORY, TROUBLE, AND CARBON MONOXIDE. OWNER TO OBTAIN PHONE LINE AND CENTRAL STATION PROVIDER. OWNER TO COORDINATE WITH CONTRACTOR.
- CONTRACTOR SHALL SUBMIT SHOP DRAWINGS, CALCULATIONS, AND MANUFACTURERS' DATA SHEETS ON ALL EQUIPMENT AND MATERIALS INDICATED ON THE DRAWINGS OR IN THE SPECIFICATIONS FOR APPROVAL BY OWNER AND ENGINEER. THE SHOP DRAWINGS, CALCULATIONS AND DATA SHEETS SHALL CONTAIN ALL NECESSARY DATA (I.E., MANUFACTURER, CATALOG NUMBER, SIZE, DIMENSIONS, CAPACITY, VOLTAGE DROPS, WIRING DETAILS AND ALL OTHER ENGINEERING DATA AND DETAILS NECESSARY) FOR COMPLETE CLARITY AND INSTALLATION.
- LOCATIONS OF ALL FIRE ALARM EQUIPMENT SHALL BE SUBJECT TO FIRE DEPARTMENT INSPECTOR APPROVAL AND THE REQUIREMENTS OF 2020 NYS UNIFORM CODE. NO CHANGE OR MODIFICATION TO THE SYSTEM OR PLANS SHALL BE PERMITTED WITHOUT WRITTEN APPROVAL FROM THE ENGINEER OF IF ANY CHANGES ARE MADE TO THE DRAWINGS PRIOR TO OR DURING INSTALLATION, AS BUILT PLANS SHALL BE PREPARED BY THE ENGINEER AND FILED WITH THE APPROPRIATE NANUET NY AGENCIES FOR FINAL ACCEPTANCE.
- THE CONTRACTOR SHALL PROVIDE THE NECESSARY DOCUMENTS REQUIRED FOR INSPECTION AND TO OBTAIN A FINAL LETTER OF APPROVAL. THIS SHALL INCLUDE 11X17 AS-BUILT DRAWING(S), AN NFPA PROGRAMMING MATRIX, AND BOTH THE STATEMENT OF OPERATION AND THE CONTRACTORS FORMS SIGNED AND SEALED BY THE APPROPRIATE PARTIES. THESE DOCUMENTS SHALL BE SUBMITTED AS NECESSARY TO THE NYC FIRE DEPARTMENT TO OBTAIN A FIRE ALARM INSPECTION. IF A LETTER OF NO APPROVAL IS ISSUED, THE CONTRACTOR SHALL CORRECT ALL ITEMS AND SUBMIT REQUEST FORMS OF CORRECTIONS TO THE FIRE DEPARTMENT TO OBTAIN A FINAL LETTER OF APPROVAL AT NO ADDITIONAL COST.
- THE CONTRACTOR SHALL PROVIDE THE OWNER WITH DOCUMENTATION FROM THE TOWN OF CLARKSTOWN FIRE DEPARTMENT OF BUILDINGS INDICATING THE SYSTEM HAS BEEN APPROVED.
- THE CONTRACTOR SHALL BE RESPONSIBLE FOR REMOVING ANY AND ALL ABANDONED FIRE ALARM CABINETS, DEVICES, AND WIRE. PAINT, PATCH AND CLEANUP SHALL ALSO BE INCLUDED.
- THE CONTRACTOR SHALL BE RESPONSIBLE FOR INTERFACING THE NEW SYSTEM WITH ANY EXISTING SYSTEM CONNECTED DEVICES (I.E. RELAYS, ETC.).
- THE FIRE ALARM RISER DIAGRAM IS FOR DESIGN PURPOSES ONLY. FIRE ALARM CONTRACTOR SHALL PROVIDE A COMPLETE RISER DIAGRAM WITH ACTUAL FIELD WIRING REQUIRED.
- INDICATION OF A RELAY INTERFACE MODULE SYMBOL "R" AT A FAN SYSTEM MOTOR (FAN ETC.) REPRESENTS ALL NECESSARY TECHNICAL MEANS TO ACCOMPLISH FAN SHUT DOWN AND RESTART. PROVIDE 4#14 IN 3/4" FROM FACP TO THE MODULE AND 2#12 IN 3/4" TO THE RESPECTIVE STARTERS TO INCORPORATE FAN SHUTDOWN.
- LOCATION OF "PB'S" (PULL BOXES) ARE SUGGESTED ROUTING. FINAL DETERMINATION IS TO BE DETERMINED IN THE FIELD TO SUIT FIELD CONDITIONS.
- FIRE ALARM CONTROL PANEL FACP SHALL HAVE BACK-UP BATTERIES.
- PROVIDE A DIGITAL ALARM COMMUNICATOR TRANSMITTER (DACT) & TWO (2) DEDICATED TELEPHONE LINES UPSTREAM OF ANY TELEPHONE SYSTEM IN THE BUILDING. THE DACT MUST BE CONNECTED TO THE FACP FOR ANNUNCIATION AT A FIRE DEPARTMENT APPROVED CENTRAL MONITORING CENTRAL STATION.
- PROVIDE THE NUMBER OF CONDUITS AS REQUIRED. CONDUITS FILL OF ALL FIRE ALARM CABLES SHALL BE AS FOLLOWS:  
3/4" CONDUIT: UP TO 6 F.A. CABLES  
1" CONDUIT: UP TO 10 F.A. CABLES  
1 1/4" CONDUIT: UP TO 17 F.A. CABLES  
1 1/2" CONDUIT: UP TO 23 F.A. CABLES  
2" CONDUIT: UP TO 38 F.A. CABLES

- THE RISER DIAGRAM INDICATES FIRE ALARM SYSTEM DEVICES, CONNECTIONS, CONDUIT RUNS, ETC. QUANTITY AND TYPE OF DEVICES SHALL BE AS INDICATED ON THE CONTRACT DRAWINGS AND/OR SPECIFICATIONS. SUBMIT ACTUAL RISERS, POINT-TO-POINT WIRING DIAGRAM INCLUDING WIRE AND CONDUIT SIZES AND INTERCONNECTIONS AS SHOP DRAWINGS. CONTRACTOR SHALL INSTALL FIRE ALARM SYSTEM ONLY AFTER ALL SHOP DRAWINGS ARE APPROVED BY THE ENGINEER OF RECORD.
- PLENUM RATED MULTI-CONDUCTOR CABLE WITH CODE COMPLIANT J-HOOK SUPPORTS ABOVE THE GRID CEILING AND HARD CEILING SHALL BE ACCEPTABLE FOR FIRE ALARM WIRING INSTALLATION. ALL OTHER LOCATIONS WHERE THE INSTALLATION CANNOT BE CONCEALED, THE FIRE ALARM WIRING SHALL BE RUN IN EXPOSED MINIMUM 3/4" CONDUIT FOR ELECTRICAL ROOMS, MECHANICAL ROOMS, AND IN WIREMOLD FOR ALL OTHER AREAS, U.O.N. ALL THE EXPOSED CONDUITS BELOW 96" AFF SHALL BE RIGID GALVANIZED CONDUIT. FLEXIBLE MC TYPE FIRE ALARM CABLE IS NOT ACCEPTABLE.
- DEVICE LAYOUT IS SHOWN FOR COVERAGE ONLY. CONTRACTOR SHALL OBTAIN PRECISE POINT TO POINT WIRING DIAGRAMS FOR EXACT QUANTITIES AND DEVICE LOCATIONS FROM CERTIFIED FIRE ALARM INSTALLER PRIOR TO INSTALLATION.
- ALL FIRE ALARM CONDUIT PENETRATIONS THROUGH EXISTING WALLS, PARTITIONS, FLOORS AND SLABS THROUGHOUT THE BUILDING SHALL BE PROVIDED WITH FIRESTOPPING MATERIAL AS PER DETAILS SHOWN ON CONTRACT DRAWINGS.
- IONIZATION TYPE SMOKE DETECTORS ARE NOT PERMITTED.
- ALL WIRING FOR FIRE ALARM SYSTEM SHALL BE FLUOROPOLYMER "TEFLON" TYPE CABLING AND SHALL MEET THE REQUIREMENTS UL 1424 AND UL 910 AS FOLLOWS:  
A. A MINIMUM TEMPERATURE RATING OF 150 DEGREES CELSIUS.  
B. A MINIMUM AVERAGE INSULATION THICKNESS OF 15 MILS.  
C. A MINIMUM AVERAGE JACKET THICKNESS OF 25 MILS.  
D. THE COLOR OF THE CABLE SHALL BE RED.  
E. THE CABLE SHALL BE A TYPE FPLP (PLENUM TYPE).  
F. THE CABLE SHALL BE VISUALLY MARKED EXTERNALLY THAT IT MEETS THE ABOVE REQUIREMENTS, AS IS LISTED BY UL.

- SUBMIT AS BUILT UPON COMPLETION OF INSTALLATION TO THE ENGINEER AND THE BUILDING MANAGER. DRAWINGS ARE TO BE PREPARED USING AUTOCAD RELEASE R2004 OR ABOVE.
- THIS CONTRACTOR MUST PREPARE ALL DOCUMENTATION REQUIRED FOR RECEIVING A PERMIT AND FOR FILING. THIS DRAWING IS FOR DESCRIPTION OF SCOPE OF WORK AND IS FOR REFERENCE ONLY. CONTRACTOR SHALL SUBMIT TO GREENMAN PEDERSEN, INC. A COMPLETE SET OF DRAWINGS FOR REVIEW. SET SHALL INCLUDE A RISER DIAGRAM, FLOOR PLAN WITH POINT TO POINT WIRING, SEQUENCE OF OPERATIONS, MATRIX, CIRCUIT CALCULATIONS AND ALL APPLICABLE NOTES FOR FILING AND FOR INSTALLATION.

- THE CONTRACTOR SHALL RETAIN A NY STATE PE TO SIGN AND SEAL ALL NECESSARY DOCUMENTS REQUIRED FOR INSPECTION AND TO OBTAIN A FINAL LETTER OF APPROVAL. IF A LETTER OF NO APPROVAL IS ISSUED, THE CONTRACTOR SHALL CORRECT ALL ITEMS AND SUBMIT A SIGNED AND SEALED CERTIFICATE OF CORRECTION TO THE NEW JERSEY FIRE DEPARTMENT TO OBTAIN A FINAL LETTER OF APPROVAL AT NO ADDITIONAL COST.

- LOCATION OF DEVICES AND EQUIPMENT ARE APPROXIMATE. FINAL LOCATIONS MUST BE DETERMINED ACCORDING TO THE SITE CONDITIONS.

- THE CONTRACTOR SHALL CONTRACT WITH THE OWNER'S FIRE ALARM VENDOR TO PROVIDE SERVICES RELATED TO THE BUILDING FIRE ALARM SYSTEM. THE WORK INCLUDES ALL NECESSARY FIRE ALARM SYSTEM SHUTDOWNS FOR GENERAL CONSTRUCTION ACTIVITIES, INCLUDING ANY SERVICES BY THE BUILDING FIRE ALARM VENDOR, TO SHUT DOWN THE SYSTEM AT THE BEGINNING OF WORK ACTIVITIES AND TO RE-ACTIVATE AT THE END OF WORK ACTIVITIES, WITH STANDARD BUILDING NOTIFICATIONS AND PROCEDURES INCLUDING MAINTAINING DAILY RECORD DOCUMENTATION, FIRE WATCH, ETC.

- TESTS OF THE FIRE ALARM SYSTEM SHALL BE CONDUCTED IN THE PRESENCE OF FIRE INSPECTOR FROM HE TOWN OF CLARKSTOWN, NEW CITY, NEW YORK.

- CONTRACTOR TO OBTAIN FIRE ALARM BUILDING VENDOR FROM OWNER. FIRE ALARM SYSTEM SHALL BE: HONEYWELL SILENT KNIGHT 6700, OR APPROVED EQUIVALENT.

DRAWING LIST	
DWG NUMBER	DRAWING TITLE
FA001	FIRE ALARM GENERAL NOTES
FA002	FIRE ALARM RISER AND IO MATRIX
FA101	FIRE ALARM FIRST FLOOR - INSTALLATION
FA102	FIRE ALARM SECOND FLOOR - INSTALLATION

**FIRE DETECTION & ALARM SYSTEM SYMBOL LIST**

SYMBOL	DESCRIPTION
	FIRE ALARM CONTROL PANEL MOUNTED CENTER LINE 4'-0" AFF. WITH INTEGRAL "DACT" DIGITAL ALARM COMMUNICATOR TRANSMITTER FOR CENTRAL STATION NOTIFICATION. SEMI-FLUSHED MOUNT ON AN EXISTING WALL.
	FIRE ALARM REMOTE ANNUNCIATOR MOUNTED 4'-0" AFF. SURFACE MOUNTED ON WALL. SEMI-FLUSH ON NEW CONSTRUCTION.
	WALL MOUNTED FIRE SIGNAL STROBE (NUMBERING INDICATES RATED CANDELA). STROBES SHALL BE WALL-MOUNTED SUCH THAT THE TOP OF STROBE LENS IS LOCATED AT 96" ABOVE THE FINISHED FLOOR OR 6" BELOW THE CEILING, WHICHEVER IS LOWER. IN NO CASES STROBE LENSE SHALL BE INSTALLED BELOW 80" A.F.F.
	CEILING MOUNTED FIRE SIGNAL STROBE. (NUMBERING INDICATES RATED CANDELA)
	CEILING MOUNTED FIRE SIGNAL HORN WITH FIRE SIGNAL STROBE (NUMBERING INDICATES RATED CANDELA).
	WALL MOUNTED FIRE SIGNAL HORN WITH FIRE SIGNAL STROBE (NUMBERING INDICATES RATED CANDELA). HORN WITH FIRE SIGNAL STROBES SHALL BE WALL-MOUNTED SUCH THAT THE TOP OF STROBE LENS IS LOCATED AT 96" ABOVE THE FINISHED FLOOR OR 6" BELOW THE CEILING, WHICHEVER IS LOWER. SUBSCRIPT 'G' DENOTES WITH GUARD. 'WP' INDICATES WEATHERPROOF. IN NO CASES STROBE LENSE SHALL BE INSTALLED BELOW 80" A.F.F.
	CEILING MOUNTED SMOKE DETECTOR. SUPERSCRIPIT "TOS" DENOTES TOP OF STAIR SUPERSCRIPIT "CO" DENOTES PROVIDE AS COMBINATION CARBON MONOXIDE SMOKE DETECTOR. PROVIDE WITH CO SOUNDER BASE.
	FIRE ALARM PULL STATION WITH DOUBLE ACTION TYPE MOUNTED MIN 3'-6" AND MAX 4'-0" FROM THE FLOOR LEVEL TO THE ACTIVATING HANDLE.
	CONTROL MODULE (DIGITAL CONTACT)
	MONITORING MODULE (DIGITAL CONTACT)
	24V RELAY OUTPUT
	DOOR HOLDER
	AUTOMATIC TRANSFER SWITCH

**SCOPE OF WORK:**

THE WORK REQUIRES PROVIDING A NEW FULLY FUNCTIONAL FIRE ALARM SYSTEM AS DETAILED IN THE CONTRACT DOCUMENTS AND SPECIFICATIONS. THE WORK GENERALLY REQUIRES THE FOLLOWING:

- REMOVE EXISTING FIRE ALARM SYSTEM AND ITS COMPONENTS AFTER NEW APPROVED FIRE ALARM SYSTEM IS INSTALLED.
- INSTALL NEW MANUAL AND AUTOMATIC FIRE ALARM SYSTEM.
- RE-PROGRAM THE EXISTING COMBINATION OF FIRE ALARM AND SECURITY ALARM SYSTEM TO OPERATE AS TWO SEPARATE SYSTEMS.
- COORDINATE WITH THE FIRE ALARM VENDOR FOR ANY ADDITIONAL ANCLLARY COMPONENTS REQUIRED FOR A FUNCTIONAL CODE COMPLIANT SYSTEM INSTALLATION.
- PROVIDE NEW WIRING AND CONDUITS FOR CONNECTION TO NEW DEVICES AND EQUIPMENT AS REQUIRED FOR A COMPLETE SYSTEM INSTALLATION.
- INSTALL NEW AUDIBLE/VISUAL DEVICES, AREA SMOKE DETECTORS, CO DETECTORS, ETC, AS INDICATED ON PLANS.

**SPECIAL INSPECTIONS**

SPECIAL INSPECTIONS REQUIRED IN ACCORDANCE WITH SECTION CHAPTER 17 AND THE APPLICABLE SECTIONS OF THE 2020 NEW YORK STATE INTERNATIONAL CODE ARE LISTED IN THE FOLLOWING TABLES:

THE CONTRACTOR MUST NOTIFY THE ENGINEER FOR CONTROLLED INSPECTIONS AT LEAST 72 HOURS BEFORE THE SPECIFIC WORK COMMENCES.

THE "AUTHORITY" SHALL BE RESPONSIBLE FOR THE FOLLOWING CONTROLLED INSPECTIONS:

FIRE-RESISTANT PENETRATIONS AND JOINTS

FIRE ALARM SYSTEM WIRING REQUIREMENT	
FUNCTION	TYPE
ADDR. LOOP WIRING/DATA	1 TWISTED PAIR #14 AWG., U.O.N.
COMBINATION HORN/STROBE	2 PAIR #14 AWG, U.O.N.
HORN	1 PAIR #12 AWG, U.O.N.
STROBE	1 PAIR #12 AWG, U.O.N.
CONTROL	2 #14 AWG, U.O.N.
POWER	2#10 AWG POWER UON; SEE NOTE 2A.
CARBON MONOXIDE	3 PAIR #14 AWG (POWER, MONITOR ALARM)

NOTE 1A: VERIFY/COORDINATE WIRE SIZE REQUIREMENTS FOR DEVICES WITH SYSTEM MANUFACTURER; FINAL AWG SIZES TO FA NOTIFICATION AND INDICATING DEVICES ARE PER SYSTEM MANUFACTURER REQUIREMENTS.

NOTE 2A: UPON SELECTION OF FA SYSTEM MANUFACTURER, WHERE FA DEVICES ARE NOT INDICATED ON THE PLANS THAT REQUIRE 120V, 20A POWER CONNECTION: FOR RUNS 100-124FT, PROVIDE 2#6 AWG. RUNS 125-175FT, PROVIDE 2#4 AWG, AND RUNS 175-300FT, PROVIDE 2#2 AWG, U.O.N.

**LIST OF DRAWINGS**

FA001	FIRE ALARM GENERAL NOTES
FA002	FIRE ALARM RISER AND IO MATRIX
FA101	FIRE ALARM FIRST FLOOR - INSTALLATION
FA102	FIRE ALARM SECOND FLOOR - INSTALLATION
FA301	FIRE ALARM DETAILS

No.	Date	Revisions
3	04-10-25	ADDENDUM NO. 3
0	02-18-25	RFF SET

--	--	--

Drawn by	JL
Checked by	SH
Project No.	40034C
Scale	NONE
Date	02/18/2025

<b>GREENMAN PEDERSEN, INC</b> 2 EXECUTIVE BUILDING SUITE 202 SUDBURY, NY 10861	<b>ATZL NASHER, &amp; ZIGLER</b> 234 North Main Street New City, NY 10955
Mechanical, Electrical & Structural Engineer	Civil Engineer

RENOVATION OF ROCKLAND GREEN ADMINISTRATIVE HEADQUARTERS AND CONSTRUCTION OF AN IMMERSIVE THEATRE EXPERIENCE

172 MAIN STREET  
 NANUET, NY 10954

TOWN OF CLARKSTOWN  
 COUNTY OF ROCKLAND

**MSA**


MICHAEL SHUALE ARCHITECTS, LLP  
 140 Park Avenue New City, NY 10955 Tel 845-708-9200  
 www.shuale.com

© COPYRIGHT, MICHAEL SHUALE ARCHITECTS. ALL RIGHTS RESERVED.

Drawing Title  
**FIRE ALARM GENERAL NOTES**

Drawing No.  
**FA001**




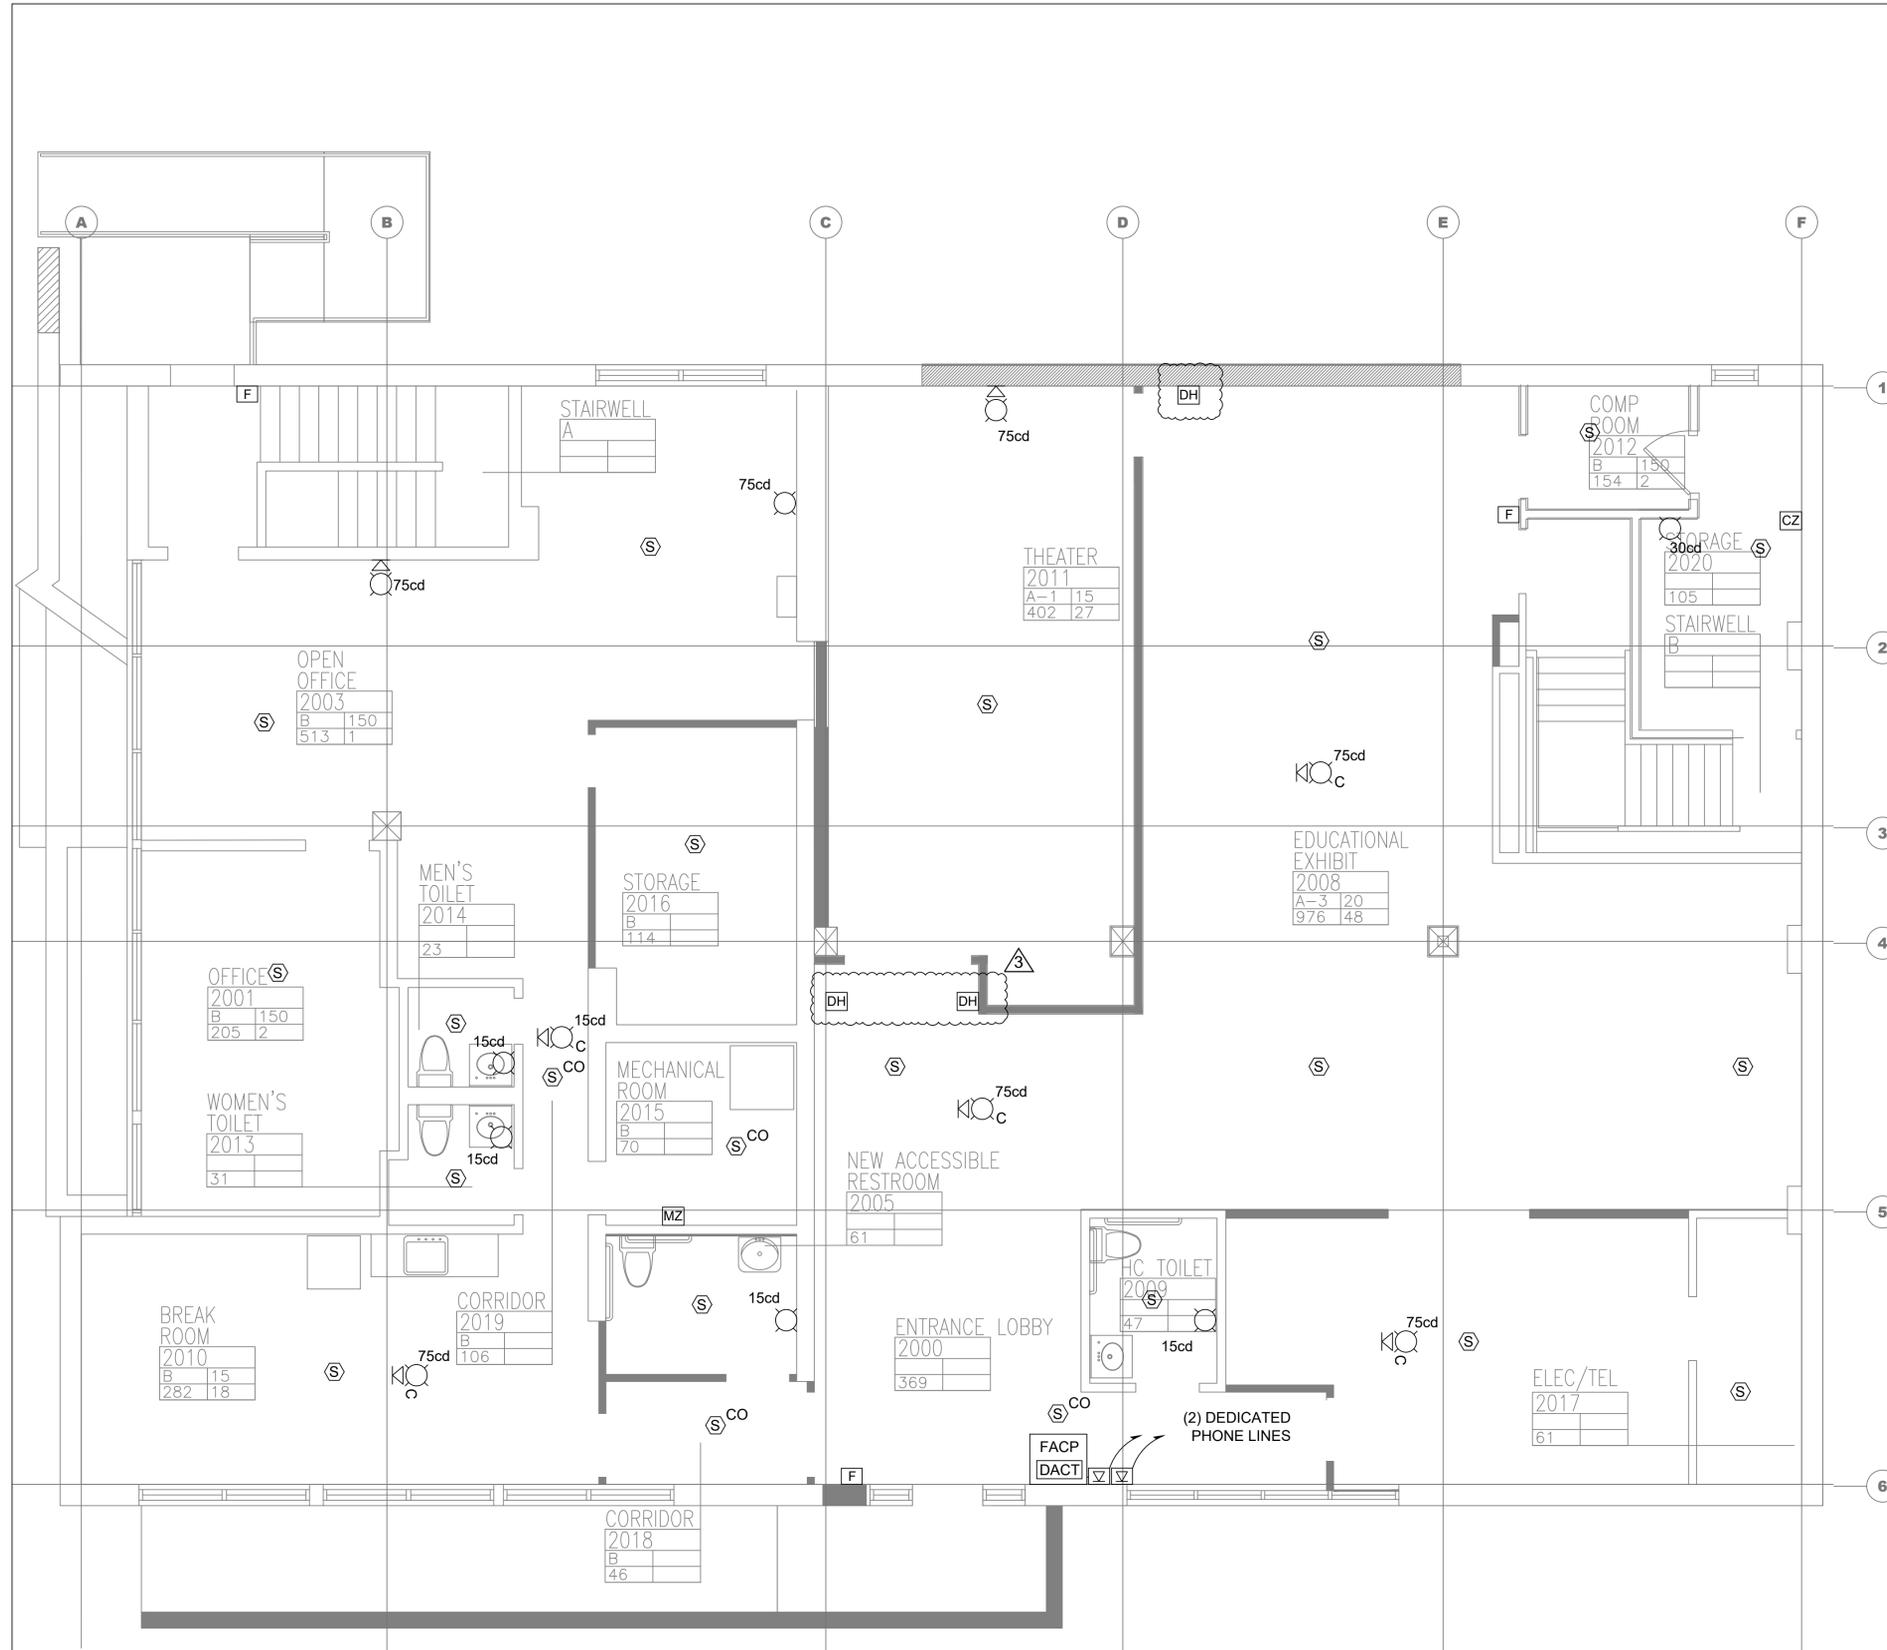

**1**  
FA101  
SCALE: 1/4" = 1'-0"  
**FIRE ALARM FIRST FLOOR PLAN - INSTALL**  
PLAN NORTH

**PLAN NOTES:**

1. PROVIDE NEW ADDRESSABLE FIRE ALARM SYSTEM WITH COMBINATION CO DETECTION. COORDINATE LOCATION OF PANELS WITH BUILDING REPRESENTATIVE.
2. ALL WORK DONE OUTSIDE THE AREA OF WORK MUST RECEIVE PRIOR AUTHORIZATION BY THE OWNER'S REPRESENTATIVE.
3. EXISTING FIRE ALARM SYSTEM TO REMAIN UNTIL NEW SYSTEM IS INSTALLED AND APPROVED.
4. PROVIDE CONTROL MODULES TO FOR HVAC UNIT SHUT DOWN AS REQUIRED.
5. DEVICES MOUNTED AT BUILDING EXTERIOR SHALL BE INSTALLED IN NEMA 3R, WEATHERPROOF ENCLOSURE(S).
6. ALL FA CONTROL MODULES AND MONITORING MODULES SHALL BE WITHIN 3'-0" FT OF THE DEVICE IT IS CONTROLLING.
7. FIRE ALARM PANELS SHALL BE SEMI-FLUSH MOUNTED.
8. ACTIVATION OF THE CARBON MONOXIDE DETECTOR SHALL AUTOMATICALLY SHUTDOWN THE EXISTING GAS-FIRED HOT WATER HEATERS. PROVIDE ALL REQUIRED APPURTENANCES FOR SHUTDOWN.
9. PROVIDE ASCO TO SHUT DOWN GAS FIRED WATER HEATER. PROVIDE 1P,20A CB IN NEAREST 208V PANEL TO POWER ASCO; RUN 3#12 IN 3/4" C TO PANEL VERIFY POWER SOURCE IN FIELD.
10. LOCATE BPS-6A BOOSTER SUPPLY POWER PANELS IN A 2-HOUR RATED ROOM (I.E. ELEC RM).
11. PROVIDE AND INSTALL CO DETECTORS, UL LISTED (UNDER UL 2075 STANDARD) WITH BUILT IN SOUNDER IS SPACED 60FT ON CENTER OR PLACED AS SPECIFIED BY MANUFACTURER WHERE DEVICE SPACE COVERAGE IS LESS THAN 60 FT. CO DETECTORS SHALL ANNUNCIATE LOCALLY "TEMPORAL 4" CODE THROUGH THE BUILT-IN SOUNDER BASE BY BOTH VISUAL AND AUDIBLE MEANS.
12. PROVIDE AND INSTALL NEW FIRE ALARM SMOKE/CO DETECTION AND ALARM SYSTEM IN ACCORDANCE WITH THE 2020 NYS BUILDING CODE. RUN 2#10,1#12G IN 3/4" C FROM FIRE ALARM PANEL TO 1P, 20A LOCKABLE CB IN PANEL.
13. PROVIDE AND INSTALL (DACT) TO SEND TROUBLE SIGNALS TO THE CLARKSTOWN FIRE DEPARTMENT'S APPROVED CENTRAL STATION. PROVIDE TWO (2) RJ-31X TELEPHONE JACKS WITH TWO (2) DEDICATED TELEPHONE LINES UPSTREAM OF ANY TELEPHONE SYSTEM IN THE BUILDING. THE RJ-31X JACKS SHALL BE MOUNTED NEXT TO THE DACT 6" X 6" IN THE HOFFMAN BOX. PROVIDE CONNECTION BETWEEN DACT SYSTEM AND THE PHONE COMPANY'S DEMARCATION POINT. RUN 4#12 AWG. IN 3/4" C. PROVIDE PRIMARY POWER FOR THE NEW DACT SYSTEM FROM 1P,20A LOCKABLE CB IN 208V PANEL. RUN 2#10,1#12G IN 3/4" C FROM DACT TO PANEL.
14. PROVIDE AND INSTALL (2) NEW DEDICATED TELEPHONE LINES FOR FIRE ALARM SYSTEM.

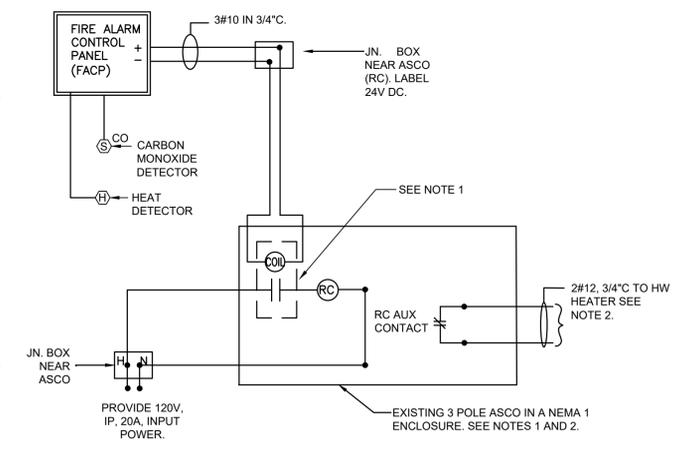

**2**  
FA101  
SCALE: NONE  
**GAS-FIRED HOT WATER HEATER POWER SHUT-DOWN USING INTERRUPT SIGNAL FROM CO & HEAT DETECTOR SCHEMATIC WIRING DIAGRAM**

**GAS-FIRED HOT WATER HEATER DETAIL NOTES:**

1. GAS-FIRED WATER HEATER SHALL SHUT DOWN UPON ACTIVATION OF CARBON MONOXIDE AND HEAT DETECTORS.
2. PROVIDE NEW ASCO (EATON MODEL: C30CN-M-3-4-A-D-2-A0 WITH AUXILIARY CONTACTS AS REQUIRED) FOR SHUT DOWN OF WATER HEATER LOCATED IN ROOM 2015. THE RELAY SHOULD BE ACTIVATED BY FACP UPON ACTIVATION OF CARBON MONOXIDE DETECTION. THE ENTIRE COMBINATION OF ASCO AND ACCESSORY SHALL BE ASSEMBLED IN A NEMA ENCLOSURE AND SHALL BE INSTALLED NEAR THE HWH. ALL CONTACTS WIRED TO TERMINAL STRIPS FOR EASY CONNECTIONS.
3. ASCO NORMALLY CLOSED AUXILIARY CONTACT (ACCESSORY) SHALL BE INCORPORATED IN THE GAS-FIRED HOT WATER HEATER CONTROL CIRCUIT SHUT DOWN THE HOT WATER HEATER UPON ACTIVATION OF THE ASCO RC SWITCH AS INDICATED.
4. QUANTITIES OF RELAYS SHOWN FOR INFORMATION ONLY. PROVIDE QUANTITIES AS REQUIRED FOR COMPLETE OPERATION.
5. CONTRACTOR SHALL VERIFY EXISTING FEEDERS AT THE LOAD SIDE CONNECT TO THE RC SWITCH CONTACTS, SO THAT THE POWER SUPPLY TO THE WATER HEATER WILL SHUT DOWN UPON ACTIVATION OF THE CARBON MONOXIDE AND HEAT DETECTORS.

0 1/2 1  
IF THIS BAR DOES NOT MEASURE 1" THEN DRAWING IS NOT TO FULL SCALE

No.	Date	Revisions
3	04-10-25	ADDENDUM NO. 3
0	02-18-25	RFF SET


Drawn by	JL
Checked by	SH
Project No.	40034G
Scale	
Date	02/18/2025

<b>GREENMAN PEDERSEN, INC</b> 2 EXECUTIVE BOULEVARD SUITE 202 ROCKLAND, NY 10961	<b>ATZL NASHER, &amp; ZIGLER</b> 254 North Main Street New City, NY 10956
Mechanical, Electrical & Structural Engineer	Civil Engineer

**RENOVATION OF ROCKLAND GREEN ADMINISTRATIVE HEADQUARTERS AND CONSTRUCTION OF AN IMMERSIVE THEATRE EXPERIENCE**  
TOWN OF CLARKSTOWN, COUNTY OF ROCKLAND  
172 MAIN STREET, NEW CITY, NY 10954




© COPYRIGHT, MICHAEL SHILALE ARCHITECTS, ALL RIGHTS RESERVED.  
Drawing Title  
**FIRE ALARM FIRST FLOOR - INSTALLATION**  
Drawing No.  
**FA101**

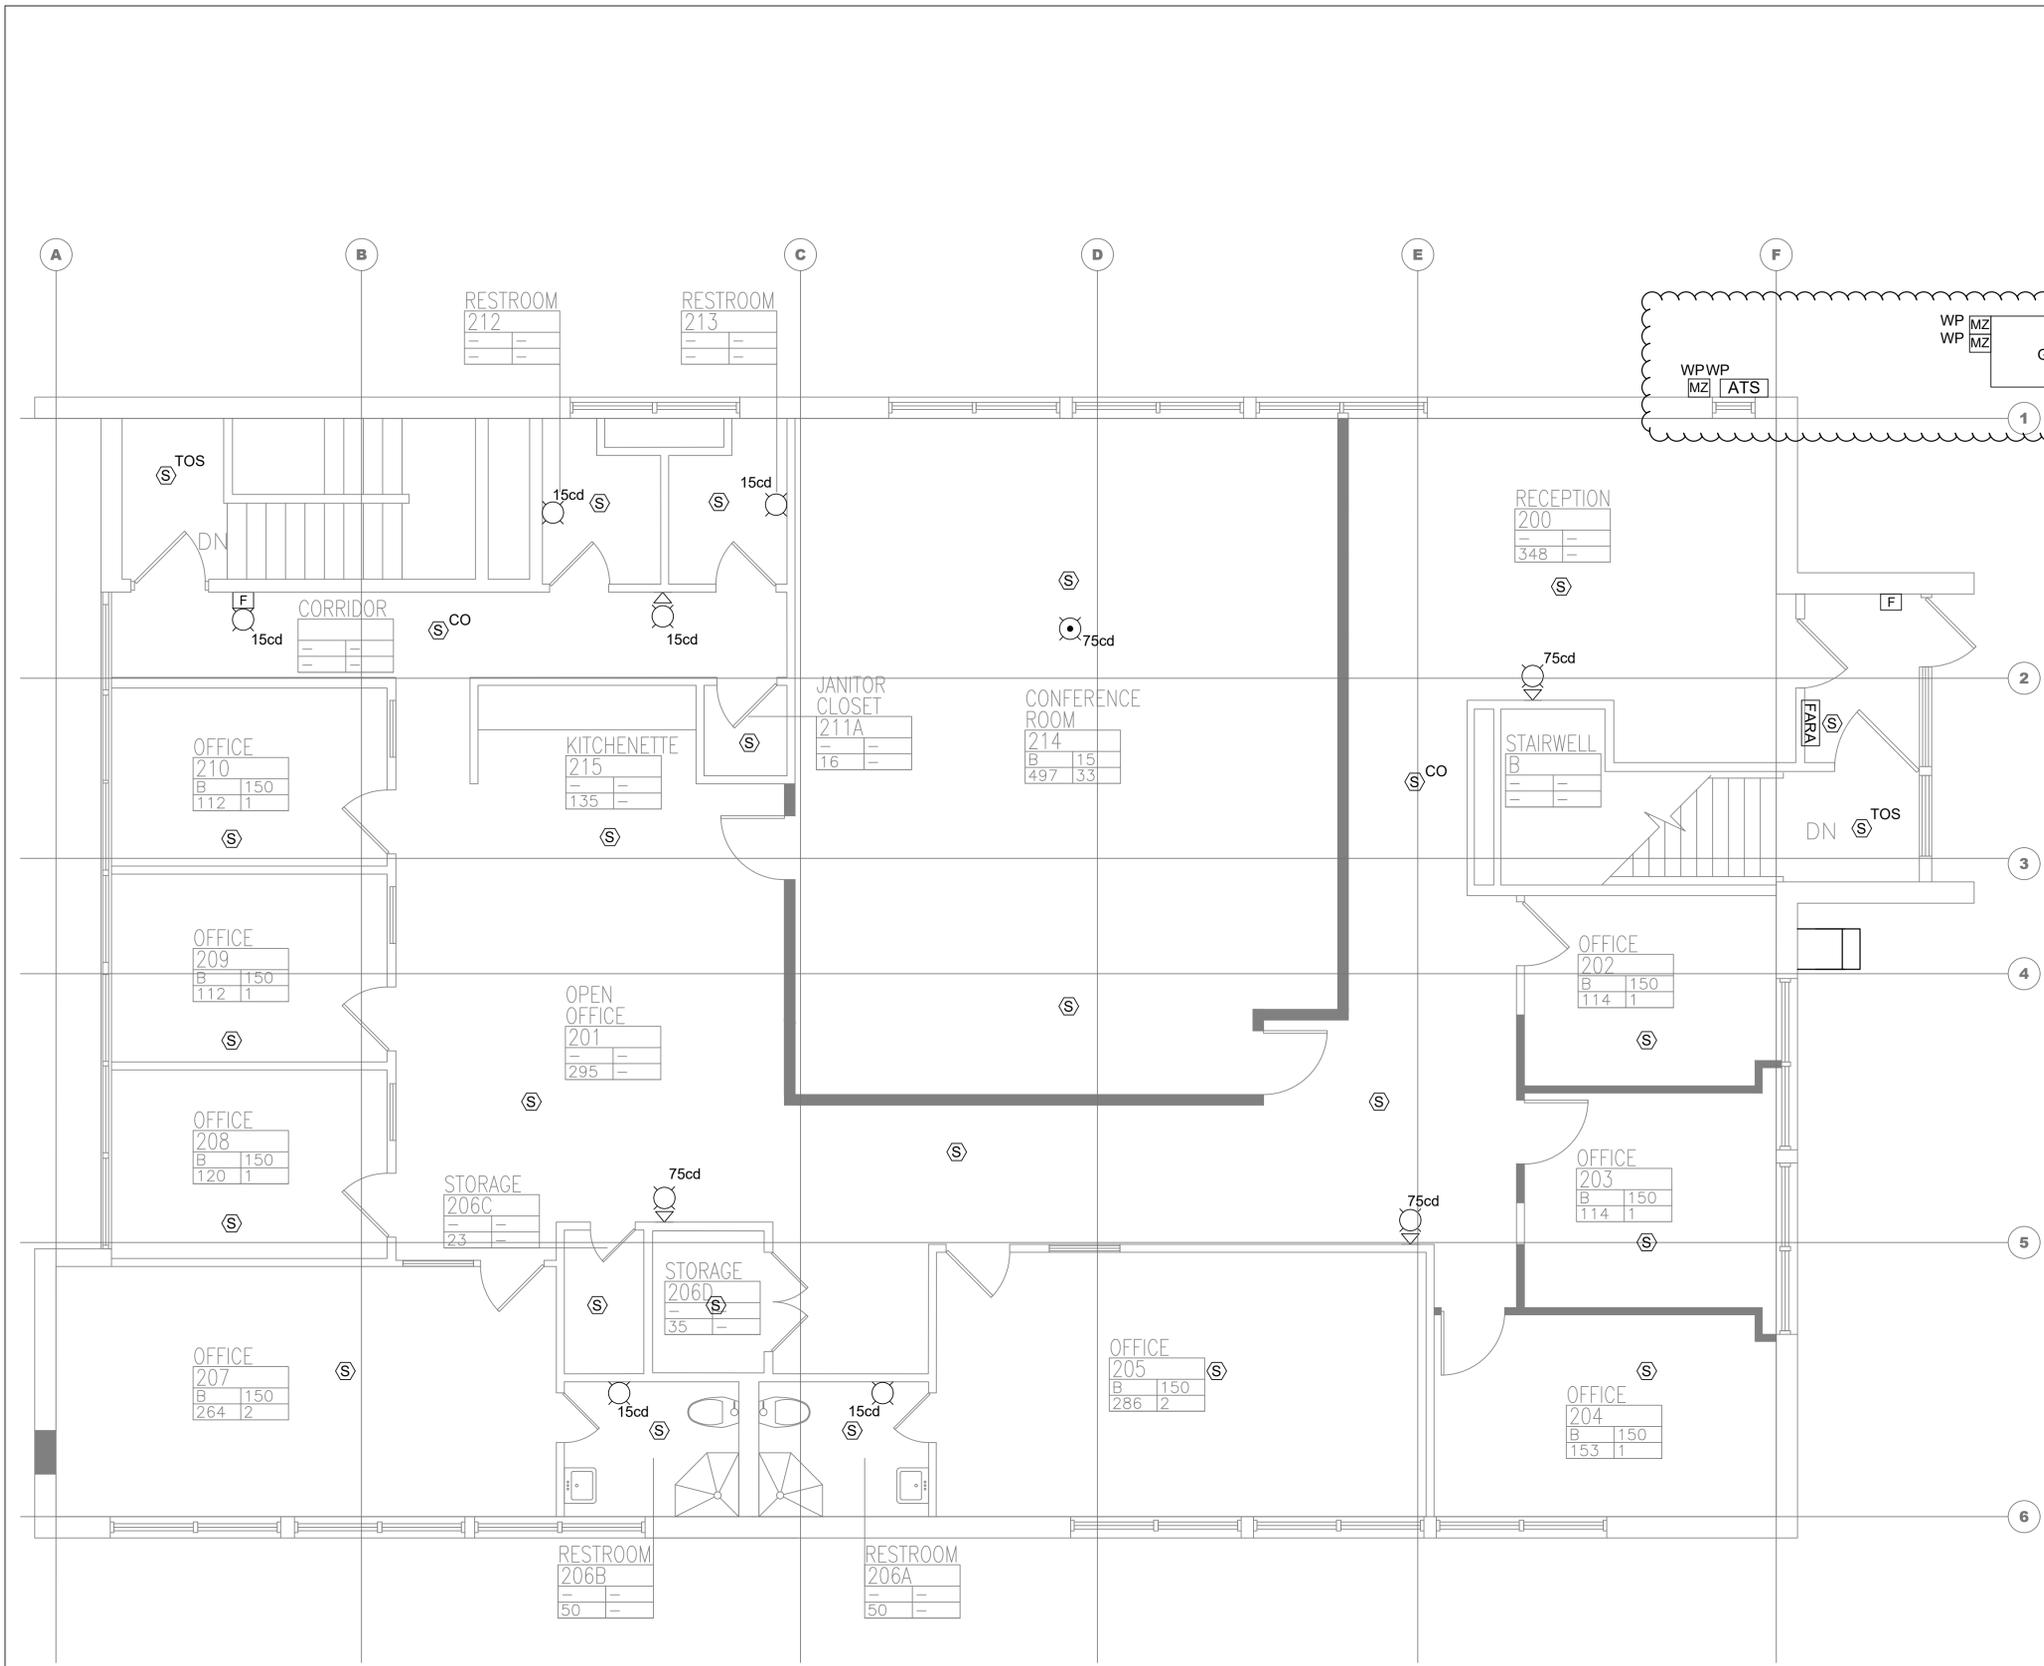

**PLAN NOTES:**

1. PROVIDE NEW ADDRESSABLE FIRE ALARM SYSTEM WITH COMBINATION CO DETECTION. COORDINATE LOCATION OF PANELS WITH BUILDING REPRESENTATIVE.
  2. ALL WORK DONE OUTSIDE THE AREA OF WORK MUST RECEIVE PRIOR AUTHORIZATION BY THE OWNER'S REPRESENTATIVE.
  3. EXISTING FIRE ALARM SYSTEM TO REMAIN UNTIL NEW SYSTEM IS INSTALLED AND APPROVED.
  4. PROVIDE CONTROL MODULES TO FOR HVAC UNIT SHUT DOWN AS REQUIRED.
5. DEVICES MOUNTED AT BUILDING EXTERIOR SHALL BE INSTALLED IN NEMA 3R, WEATHERPROOF ENCLOSURE(S).
6. ALL FA CONTROL MODULES AND MONITORING MODULES SHALL BE WITHIN 3'-0" FT OF THE DEVICE IT IS CONTROLLING.
7. FIRE ALARM PANELS SHALL BE SEMI-FLUSH MOUNTED.

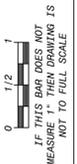

No.	Date	Revisions
3	04-10-25	ADDENDUM NO. 3
0	02-18-25	RFF SET

Drawn by	JL
Checked by	SH
Project No.	40034G
Scale	
Date	02/18/2025

<b>GREENMAN PEDERSEN, INC</b> 2 EXECUTIVE BOULEVARD SUITE 202 SPRINGFIELD, NY 10901	<b>ATZL NASHER, &amp; ZIGLER</b> 204 North Main Street New City, NY 10956
Mechanical, Electrical & Structural Engineer	Civil Engineer

**RENOVATION OF ROCKLAND GREEN ADMINISTRATIVE HEADQUARTERS AND CONSTRUCTION OF AN IMMERSIVE THEATRE EXPERIENCE**

172 MAIN STREET  
NAUTLET, NY 10964

TOWN OF CLANSTON  
COUNTY OF ROCKLAND



© COPYRIGHT, MICHAEL SHILALE ARCHITECTS, ALL RIGHTS RESERVED.
Drawing Title <b>FIRE ALARM SECOND FLOOR - INSTALLATION</b>
Drawing No. <b>FA102</b>

1  
FA102 FIRE ALARM SECOND FLOOR PLAN - INSTALL  
SCALE: 1/4" = 1'-0"





Howard T. Phillips, Jr.  
Chairman


Gerard M. Damiani, Jr.  
Executive Director

Rockland County Solid Waste Management Authority

---


**ATTACHMENT 2  
TO  
ADDENDUM 3 TO RFP 2025-02**

**NEW DRAWINGS**

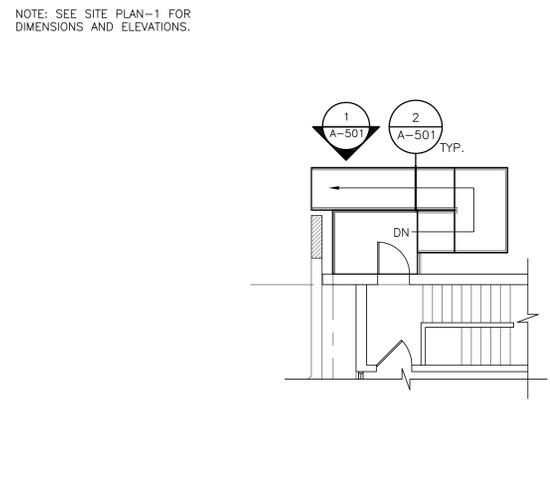

**4 NORTH RAMP PLAN**  
SCALE: 1/8"=1'-0"


NOTE: SEE SITE PLAN-1 FOR DIMENSIONS AND ELEVATIONS.

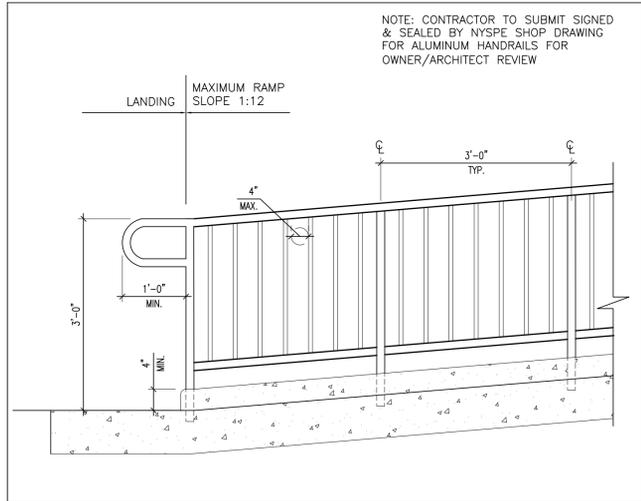


**1 ELEVATION**  
SCALE: 3/4"=1'-0"

NOTE: CONTRACTOR TO SUBMIT SIGNED & SEALED BY NYSPE SHOP DRAWING FOR ALUMINUM HANDRAILS FOR OWNER/ARCHITECT REVIEW

**2 RAMP SECTION DETAIL**  
SCALE: 3/4"=1'-0"

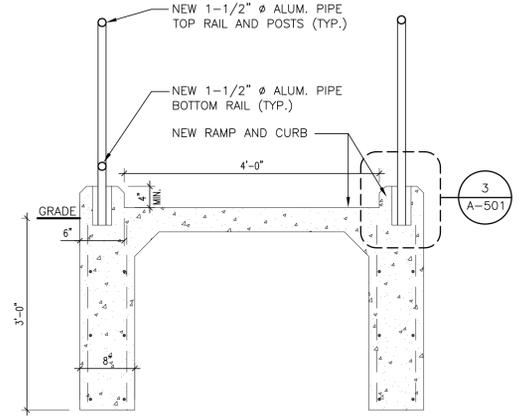

**3 HANDRAIL POST DETAIL**  
SCALE: 3"=1'-0"

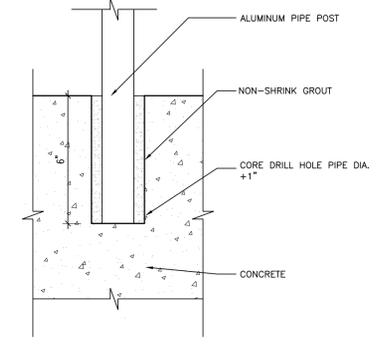

IF THIS BAR DOES NOT MEASURE 1" THEN GRANITE/IS NOT TO FULL SCALE

IT IS A VIOLATION OF THE LAW FOR ANY PERSON, UNLESS ACTING UNDER THE DIRECTION OF A LICENSED ARCHITECT, TO ALTER AN ITEM IN ANY WAY.

Drawn By	MAL/JR
Checked by	MS/JC
Project No.	40034G
Scale	AS NOTED
Date	03-20-23

Mechanical, Electrical & Structural Engineer:	<b>GREENMAN PEDERSEN, INC</b> 200 WEST 42ND STREET SUITE 202 SUFFERN, NY 10901
	<b>ATZLNASHER, &amp; ZIGLER</b> 224 North Main Street New City, NY 10956
Civil Engineer:	

RENOVATION OF ROCKLAND GREEN ADMINISTRATIVE HEADQUARTERS AND CONSTRUCTION OF AN IMMERSIVE THEATRE EXPERIENCE

150 MAIN STREET  
ROCKLAND, NY 10986

© COPYRIGHT, MICHAEL SHILALE ARCHITECTS, ALL RIGHTS RESERVED.

Drawing Title  
**EXTERIOR DETAILS**

**MICHAEL SHILALE ARCHITECTS, L.L.P.**  
140 Park Avenue New York, NY 10056 Tel 845-708-9200  
www.shilale.com

Drawing No.  
**A-501**